


L.A.U.D.
M31
1-7-65

WATER WELL DRILLERS LOG

Date: 1-7-65, 1965, Driller: M. E. DOMESTIC
(Name)

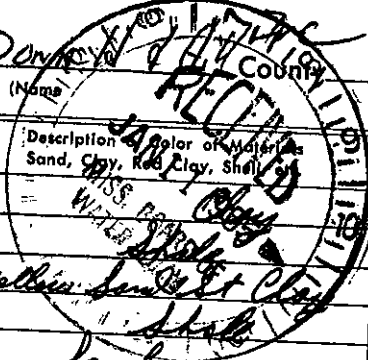

(1) Owner of Land: Rev. WEST BUSBEE
(Name)
Rt #5, Meridian, MS
(Address)

(2) Location: 1/4, 1/4, Sec. 19 6N 15E
(T R S)
3 miles West of Meridian
(distance) (direction) (Nearest Town)

(3) Topography: X
(Hilly) (Flat) (Level)

(4) Purpose of Well: DOMESTIC
(Domestic Irrigation, Municipal, Industrial, Other)

Description	Color of Water	Thick-ness Feet	Depth Feet
		0	20
		20	40
<u>yellow sand</u>		40	60
<u>shale</u>		60	90
<u>lumpy shale</u>		90	120
<u>shale</u>		120	145
<u>sand</u>		145	190
<u>shale</u>		190	210
<u>sand</u>		210	240
		240	260

Information upon completion of well:

(1) Diameter 2" WELL inches.

(2) Total Depth 260' feet.

(3) Water Level 70' feet below top of ground.

(4) Cased to 152', Size 2"

(5) Screen: Size _____, Length _____

(6) Were any formations sealed against pollution?
_____yes, _____no.

If YES depth of formation _____

Why _____

Drillers Remarks: _____

Well No. _____

(Use Back Side)

Mail this copy to Board of Water Commissioners 429 Miss. St. Jackson, Miss.