

LAUD. MISSISSIPPI BOARD OF WATER COMMISSIONERS

M32

1-28-65 WATER WELL DRILLERS LOG

Date: 1-28, 1965, Driller: Mc Donald + Hill County Lauderdale

(Name)

(1) Owner of Land: Rev. Wess Buster
 (Name)
Lakewood (H. #5)
 (Address) Meridian, Miss.

(2) Location: 1/4, 1/4, Sec. 16 T. 6 N R. 15 E
 miles _____ of _____
 (distance) (direction) (Nearest Town)

(3) Topography: Hilly
 (Hilly) (Flat) (Level)

(4) Purpose of Well: DOMESTIC
 (Domestic Irrigation
 Municipal, Industrial, Other)

Description & Color of Materials Sand, Clay, Red Clay, Shell, etc.	Thick- ness Feet	Depth Feet
Clay	0	12
Lignite	12	18
Shale	18	45
F Sand	45	55
Sandy clay + shale	55	78
H Shale	78	95
Dark shale + sandy shale	95	135
H Shale	135	145
Sand stone	145	150
H Shale	150	175
F Sand	175	181
Rock	181	183
Shale + lignite str	183	210
F Sand	210	227
Sandy shale	227	245
Sand F MEDIUM str	245	260

Information upon completion of well:

(1) Diameter 2 inches.

(2) Total Depth 260 feet.

(3) Water Level 60 feet below top of ground.

(4) Cased to 165, Size 2.


(5) Screen: Size _____, Length _____.

(6) Were any formations sealed against pollution?
 _____ yes, _____ no.

If YES depth of formation _____

Why _____

Drillers Remarks: _____

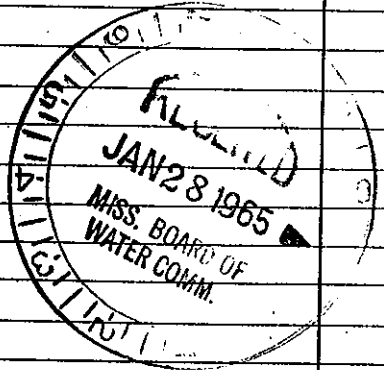

Well No.

(Use Back Side)