

L.A.U.D.
M33
3-30-65

MISSISSIPPI BOARD OF WATER COMMISSIONERS

WATER WELL DRILLERS LOG

CODFD

Date: 3-30, 1965, Driller: Bob Williams County Laud.
(Name)

(1) Owner of Land: <u>Kennith C. Matney</u> (Name)	Description & Color of Materials Sand, Clay, Red Clay, Shell, etc.	Thick- ness Feet	Depth Feet
<u>Rt 1, Valley Road, Meridian</u> (Address)	<u>Red clay</u>	<u>5</u>	<u>1-5</u>
(2) Location: <u>1/4</u> , <u>1/4</u> , Sec. <u>T</u> , R. <u></u>	<u>Blue clay</u>	<u>50</u>	<u>5-55</u>
<u>1</u> miles <u>South</u> , of <u>Meridian</u> (distance) (direction) (Nearest Town)	<u>mixed sand & clay</u>	<u>40</u>	<u>55-95</u>
(3) Topography: <u>hilly</u> (Hilly) (Flat) (Level)	<u>Blue clay</u>	<u>110</u>	<u>95-205</u>
(4) Purpose of Well: <u>Domestic</u> (Domestic Irrigation Municipal, Industrial, Other)	<u>fine gray sand</u>	<u>70</u>	<u>205-275</u>


Information upon completion of well:

- (1) Diameter 4 inches.
- (2) Total Depth 275 feet.
- (3) Water Level 42 feet below top of ground.
- (4) Cased to 120, Size 4"
- (5) Screen: Size 0, Length _____
- (6) Were any formations sealed against pollution?
 yes, no.

If YES depth of formation _____

Why surface water

Drillers Remarks: _____

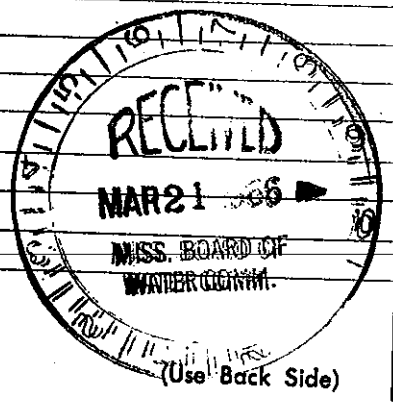

Well No. _____

tain this copy for your office files.