


MISSISSIPPI BOARD OF WATER COMMISSIONERS

WATER WELL DRILLERS LOG

10.
134

6-10-64

Date 6.10, 1964, Driller: M^o Donald Hill, Jr
Landudale County

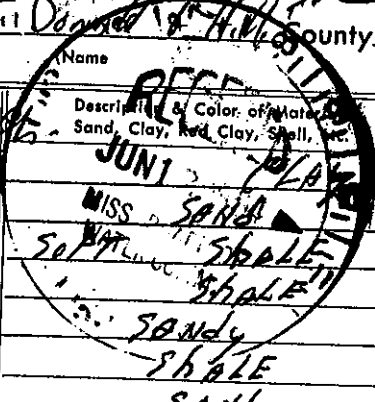

(1) Owner of Land: West Gulf mother
 (Name)
Rt. # 5, Meriden
 (Address)
 (2) Location: 1/4, 1/4, Sec. 20 T. 15E R. 6N
 (distance) (direction) (Nearest Town)
 (3) Topography: X
 (Hilly) (Flat) (Level)
 (4) Purpose of Well: DOMESTIC
 (Domestic Irrigation, Municipal, Industrial, Other)

Name	Description & Color of Material Sand, Clay, Red Clay, Shell, etc.	Thickness Feet	Depth Feet
	JUNI PLAYS	0	10
	MISS SAND	10	56
	SANDY SHALE	56	106
	SHALE	105	125
	SANDY SHALE	125	145
	SHALE	145	172
	SAND	172	205
	SHALE	205	235
	ROCK	235	238
	SAND	238	256
	SHALE	256	295
	SANDY SHALE	295	310

Information upon completion of well:

(1) Diameter 4" inches.
 (2) Total Depth 310' feet.
 (3) Water Level 139' feet below top of ground.
 (4) Cased to 222', Size 4"
 (5) Screen: Size _____, Length _____
 (6) Were any formations sealed against pollution?
 _____ yes, _____ no.

If YES depth of formation _____
 Why _____
 Drillers Remarks: _____

Well