

LAUD.
M35

MISSISSIPPI BOARD OF WATER COMMISSIONERS

5-14-65

WATER WELL DRILLERS LOG

Date: 5-14, 1965, Driller: McDonald of Hill County, Louisiana
(Name)

(1) Owner of Land: Rev. Harvey Pittman
(Name)
909-70th Place
(Address)

(2) Location: 1/4, 1/4, Sec. 19, T. 6N, R. 15E
3 miles West of Merida
(distance) (direction) (Nearest Town)

(3) Topography: (Hilly) (Flat) (Level)

(4) Purpose of Well: Domestic
(Domestic Irrigation, Municipal, Industrial, Other)

Description & Color of Materials
Sand, Clay, Red Clay, Shell, etc.

Thick-
ness
Feet

Depth
Feet


clay & sand	0	30
Shale	30	50
Shale & sand str.	50	105
Shale	105	110
Rock	110	172
Sandy shale	112	140
Shale w/sand	140	160
H. shale	160	180
Shall w/ sh.	180	210
Shale	210	225
shale fine sand	225	240
shale lime str.	240	335
M sand & shale	335	360

Information upon completion of well:

- (1) Diameter 4 inches.
- (2) Total Depth 360 feet.
- (3) Water Level 50 feet below top of ground.
- (4) Cased to 110, Size 4"
- (5) Screen: Size _____, Length _____
- (6) Were any formations sealed against pollution?
yes, no.

If YES depth of formation _____
Why _____

Drillers Remarks: _____

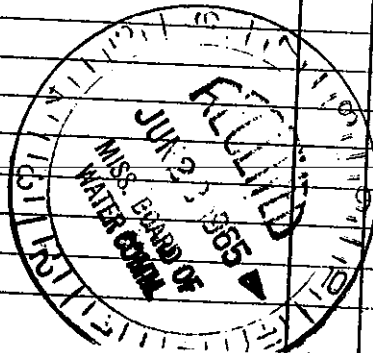

We