

LAUD. MISSISSIPPI BOARD OF WATER COMMISSIONERS


M37

1-23-64

WATER WELL DRILLERS LOG

Date: 1-23, 1964, Driller: McDaniel & Hill County, Louisiana
(Name)

	Description & Color of Materials Sand, Clay, Red Clay, Shell, etc.	Thick- ness Feet	Depth Feet
(1) Owner of Land: <u>Allen Busby</u> (Name) <u>RT #5, Meridian, MS</u> (Address)	Clay	0	15
(2) Location: <u>1/4, 1/4, Sec. 4</u> <u>6N 16E</u> T R <u>2 miles N</u> of <u>Meridian</u> (distance) (direction) (Nearest Town)	shale w/ lignite	15	50
(3) Topography: <u>Hilly</u> (Hilly) (Flat) (Level)	Red clay & sand	50	70
(4) Purpose of Well: <u>Domestic</u> (Domestic Irrigation Municipal, Industrial, Other)	shale	70	105
	Sand & sandy shale	105	118
	shale w/ lignite	118	130
	sandy shale	130	155
	shale	155	173
	Sand & sandy shale	173	200
	shale & lign.	200	207
	sandy shale & some sd	207	230
Information upon completion of well:			
(1) Diameter <u>4</u> inches.			
(2) Total Depth <u>230</u> feet.			
(3) Water Level <u>80</u> feet below top of ground.			
(4) Cased to <u>157</u> , Size <u>4</u>			
(5) Screen: Size <u>none</u> , Length _____			
(6) Were any formations sealed against pollution? _____ yes, <input checked="" type="checkbox"/> no.			
If YES depth of formation _____			
Why _____			
Drillers Remarks: <u>Suggest set pit @ 105</u>			

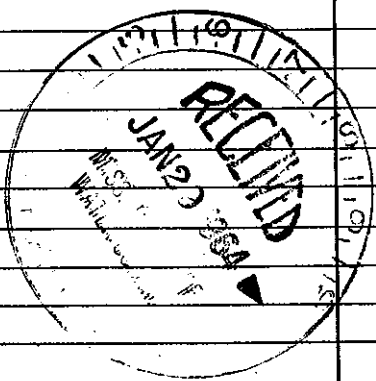

(Use Back Side)

Well No.

Mail this copy to Board of Water Commissioners 429 Miss. St. Jackson, Miss.