

Corrected 4/24/68

JOR

LAUDERDALE
M 39
10-67

MISSISSIPPI
BOARD OF WATER COMMISSIONERS
416 North State Street
Jackson, Mississippi 39201

WATER WELL DRILLERS LOG

OCTOBER 19 67 OGLETREE DRILLING LAUDERDALE
date well completed firm name county well located

LANDOWNER: BARNEY PARTRIDGE
MERIDIAN, MISS.

(mailing address)

WELL LOCATION:

sec 15 T 6 N R 15 E
S W

2.5 miles NORTH of MERIDIAN
(distance) (direction) (nearest town)

WELL PURPOSE: HOME USE
(home, irrigation, municipal, industrial)


WELL COMPLETION DATA:

- (1) diameter (inches) 4"
- (2) total depth (feet) 336
- (3) static water level (feet) 30 below above top of ground.
- (4) casing BLACK 105
(material) (depth)
(size) If telescope see back.
- (5) screen NONE
(length) (depth to top)
(size) (material)
- (6) pump 1/2 20
(HP) (yield gpm)
REA
(type power)
- (7) electric log NO
(yes or no)
(organization running log)
- (8) how well bottom plugged OPEN

description of formations encountered

from to

RED CLAY	0	10
WHITE SAND	10	20
BLUE CHALK	20	300
WHITE AND GRAY SAND	300	336

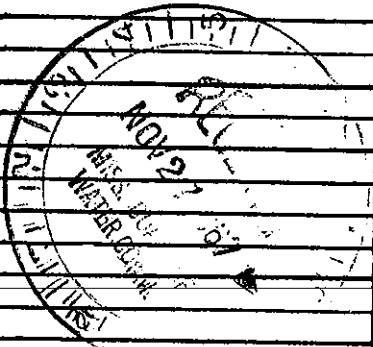

DRILLERS REMARKS: