

LAUDERDALE
 M 40
 8 LG 7

MISSISSIPPI
 BOARD OF WATER COMMISSIONERS
 416 North State Street
 Jackson, Mississippi 39201

WATER WELL DRILLERS LOG

8-30-1967 date well completed
 Jerry Drilling Co. firm name
 Land county well located

LANDOWNER:

Mr. R. H. Coats
 Rt 1, Meridian, Miss.
 (mailing address)

description of formations encountered

description of formations encountered	from	to
Yellow Clay	0	22
1" sand	22	55
Sandy shale	55	130
Shale	130	300
Sandy	300	368


WELL LOCATION:

sec 35 T 6 N R 15 E
 S W
 2 miles south of Meridian
 (distance) (direction) (nearest town)

WELL PURPOSE: Home
 (home, irrigation, municipal, industrial)

WELL COMPLETION DATA:

- (1) diameter (inches) 4"
- (2) total depth (feet) 368'
- (3) static water level (feet) 91' below top of ground.
- (4) casing 4" Blk 256' (material) (depth)
 No (size) If telescope see back.
- (5) screen No (length) (depth to top)
- (6) pump 1/2 (HP) 7 gpm (type power) (yield gpm)
 Submerg (type power)
- (7) electric log No (yes or no)
 (organization running log)
- (8) how well bottom plugged

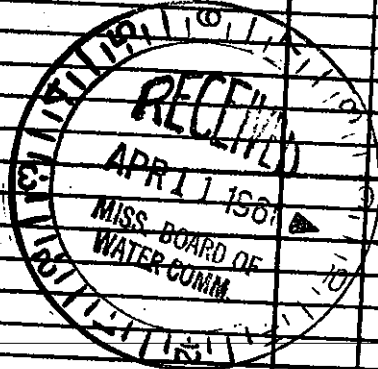

DRILLERS REMARKS: Well pumped 50 gpm with air.