

LAND  
M59  
8-62

MISSISSIPPI BOARD OF WATER COMMISSIONERS

WATER WELL DRILLERS LOG

**CODED**

Date: Aug 10, 1962, Driller: Peepert Rullodga County Sauvadeale  
(Name)


(1) Owner of Land: John Williams  
(Name)  
Rt 6 - Meridian, Miss.  
(Address)  
25 6 15  
(2) Location: 1/4, 1/4, Sec. 6 T R  
miles of  
(distance) (direction) (Nearest Town)  
(3) Topography: Hilly  
(Hilly) (Flat) (Level)  
(4) Purpose of Well: Domestic  
(Domestic Irrigation, Municipal, Industrial, Other)

Description & Color of Materials Sand, Clay, Red Clay, Shell, etc.	Thick- ness Feet	Depth Feet
<u>top soil to yellow</u>		
<u>Sandy clay + sand</u>	<u>89</u>	<u>89</u>
<u>Blue clay</u>	<u>26</u>	<u>115</u>
<u>yellow sand + sandy</u>		
<u>clay</u>	<u>38</u>	<u>153</u>
<u>soft gray sandy shale +</u>		
<u>small grey sand streaks</u>	<u>152</u>	<u>305</u>
<u>gray sandy shale</u>	<u>15</u>	<u>320</u>
<u>gray sandy shale + liquid</u>		
<u>streaks</u>	<u>13</u>	<u>333</u>
<u>gray sandy shale</u>	<u>67</u>	<u>400</u>
<u>gray sandy shale</u>		
<u>+ coarse sand streaks</u>	<u>85</u>	<u>485</u>

Information upon completion of well:

(1) Diameter 4 inches.  
(2) Total Depth 485 feet.  
(3) Water Level 270 feet below top of ground.  
(4) Cased to 315', Size 4"  
(5) Screen: Size NONE, Length \_\_\_\_\_  
(6) Were any formations sealed against pollution?  
\_\_\_\_\_ yes, \_\_\_\_\_ no.  
If YES depth of formation \_\_\_\_\_  
Why \_\_\_\_\_  
Drillers Remarks: \_\_\_\_\_

**CODED**

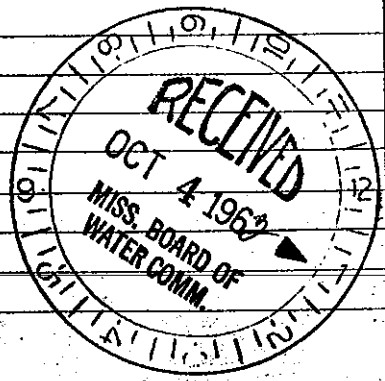

(Use Back Side)

Well No.