

LAUD.
M60
8-9-62

MISSISSIPPI BOARD OF WATER COMMISSIONERS

WATER WELL DRILLERS LOG

CODED

Date: 8-9, 1962, Driller: M.E. Donald Hiee County: Lauderdale
(Name)


(1) Owner of Land: J.T. Reed
(Name)
Rt # 1 Median
(Address)
36 6 15
(2) Location: 1/4, 1/4, Sec. T R,
_____ miles _____ of _____
(distance) (direction) (Nearest Town)
(3) Topography: _____
(Hilly) (Flat) (Level)
(4) Purpose of Well: Domestic
(Domestic Irrigation
Municipal, Industrial, Other)

Description & Color of Materials Sand, Clay, Red Clay, Shell, etc.	Thick- ness Feet	Depth Feet
<u>Sandy Clay</u>	<u>0</u>	<u>12</u>
<u>Shale</u>	<u>12</u>	<u>20</u>
<u>H. Shale</u>	<u>20</u>	<u>40</u>
<u>Soft Shale</u>	<u>40</u>	<u>69</u>
<u>Rock</u>	<u>69</u>	<u>70</u>
<u>Shale</u>	<u>70</u>	<u>90</u>
<u>Soft Shale</u>	<u>90</u>	<u>95</u>
<u>H. Shale</u>	<u>95</u>	<u>110</u>
<u>Soft Shale</u>	<u>110</u>	<u>148</u>
<u>Shaly Shale</u>	<u>148</u>	<u>181</u>
<u>Shale</u>	<u>181</u>	<u>190</u>

Information upon completion of well:

(1) Diameter 3 inches.
(2) Total Depth 190 feet.
(3) Water Level 55 feet below top of ground.
(4) Cased to 105, Size _____
(5) Screen: Size ✓, Length _____
(6) Were any formations sealed against pollution?
_____ yes, _____ no.

CODED

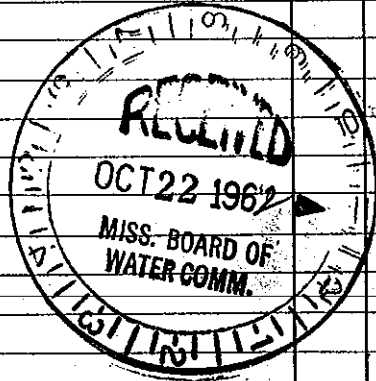

If YES depth of formation _____
Why _____
Drillers Remarks: _____

Well No.

(Use Back Side)