

M63
4-1-64

WATER WELL DRILLERS LOG

CODED

Date: 4-1, 1964, Driller: McDonald & Hill County Landersdale
(Name)


(1) Owner of Land: R J Francis
(Name)
RT 5
(Address)
3 6 15
(2) Location: 1/4, 1/4, Sec. 6 15 T 1 R 15
8 miles N of Meridian
(distance) (direction) (Nearest Town)
(3) Topography: Hilly
(Hilly) (Flat) (Level)
(4) Purpose of Well: Domestic
(Domestic Irrigation
Municipal, Industrial, Other)

Description & Color of Materials Sand, Clay, Red Clay, Shell, etc.	Thick- ness Feet	Depth Feet
Clay - sandy clay	0	22
shale	22	70
sandy shale & sand	70	82
shale w/ lg sand	82	130
sandy shale & sand	130	147
shale w/ some lg	147	158
sand w/ shale str	158	190
shale	190	198
sand - sandy shale	198	220
shale w/ thin str	220	232
shale	232	248
sand - sandy shale	248	270
shale w/ some lg	270	360
sandy shale	360	372
shale	372	380
sand w/ sandy shale	380	400
shale (sandy)	400	430
shale	430	440
sandy shale	440	460
sand w/ some shale	460	500

Information upon completion of well:

(1) Diameter: 4 inches.
(2) Total Depth: 500 feet.
(3) Water Level: 115 feet below top of ground.
(4) Cased to: 277, Size 4
(5) Screen: Size _____, Length _____
(6) Were any formations sealed against pollution?
_____ yes, _____ no.

If YES depth of formation _____
Why _____
Drillers Remarks: _____

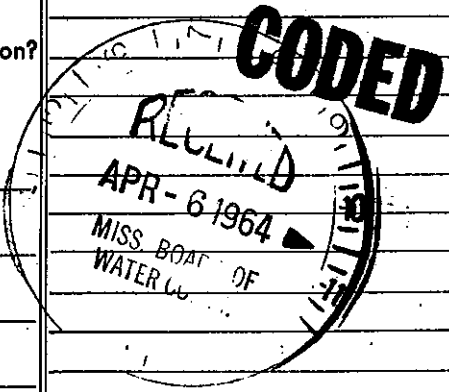

(Use Back Side)

Well No.