

LAUD.  
M 64  
1-4-65

# WATER WELL DRILLERS LOG

# CODED

Date: 1-4, 1965, Driller: M. E. Donald & H. V. Inc County Lauderdale  
(Name)


(1) Owner of Land: Jessie MOSLEY  
(Name)  
PH1 MERIDIAN  
(Address)  
(2) Location: 33 6 15  
1 miles South of Meridian  
(distance) (direction) (Nearest Town)  
(3) Topography: X  
(Hilly) (Flat) (Level)  
(4) Purpose of Well: DOMESTIC  
(Domestic Irrigation, Municipal, Industrial, Other)

Description & Color of Materials Sand, Clay, Red Clay, Shell, etc.	Thick- ness Feet	Depth Feet
CLAY	0	28
CLAY ST SAND	20	40
SHALE	40	90
SAND ST SHALE	90	138
SHALE	138	165
ROCK	165	170
SHALE	170	290
SANDY SHALE	290	360

### Information upon completion of well:

(1) Diameter 4" WELL inches.  
(2) Total Depth 360' feet.  
(3) Water Level 112' feet below top of ground.  
(4) Cased to 170', Size 4"  
(5) Screen: Size \_\_\_\_\_, Length \_\_\_\_\_  
(6) Were any formations sealed against pollution?  
\_\_\_\_\_yes, \_\_\_\_\_no.

# CODED

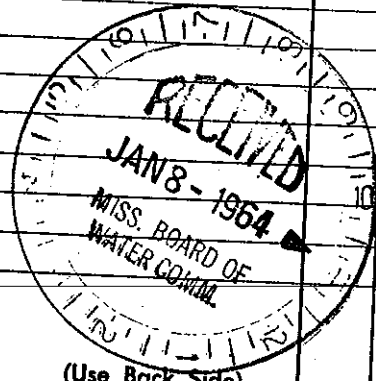

(Use Back Side)

Well No.

Mail this copy to Board of Water Commissioners 429 Miss. St. Jackson, Mis: