

Lauderdale
M119
11-15-79

MISSISSIPPI
BOARD OF WATER COMMISSIONERS
416 North State Street
Jackson, Mississippi 39201

CODED

WATER WELL DRILLERS LOG

11/15/79 Date well completed
1979 Jung Drilling Co firm name
Laud county well located


LANDOWNER: <i>Meridian Fish Hatchery</i>	description of formations encountered	from	to
		<i>Meridian Miss. (mailing address)</i>	
	<i>yellow clay</i>	0	12
	<i>clay</i>	12	40
	<i>clay</i>	40	90
	<i>Sandy clay</i>	90	135
	<i>clay</i>	135	190
	<i>sandy clay</i>	190	210
	<i>Clay + sand</i>	210	400
	<i>sand</i>	400	450
	<i>Clay + sandy sand</i>	450	660
	<i>sand</i>	660	750
	<i>clay</i>	750	780
	<i>sand</i>	780	880

WELL LOCATION:
sec. 34 T 6 N R 15 E
S W
1 1/2 miles S of Meridian
(distance) (direction) (nearest town)

WELL PURPOSE: Domestic supply
(home, irrigation, municipal, industrial)

WELL COMPLETION DATA:

- (1) diameter (inches) 6"
- (2) total depth (feet) 880
- (3) static water level (feet) 6 ^{below} top of ground.
- (4) casing Steel 840
(material) (depth)
4"
(size) if telescope see back.
- (5) screen 40' 840
(length) (depth to top)
4 stainless steel
(size) (material)
- (6) pump 7 1/2 100 @ 7'
(HP) (yield gpm)
Sub
(type power)
- (7) electric log Y
(yes or no)
ME5
(organization running log)
- (8) how well bottom plugged Wks
Kakar

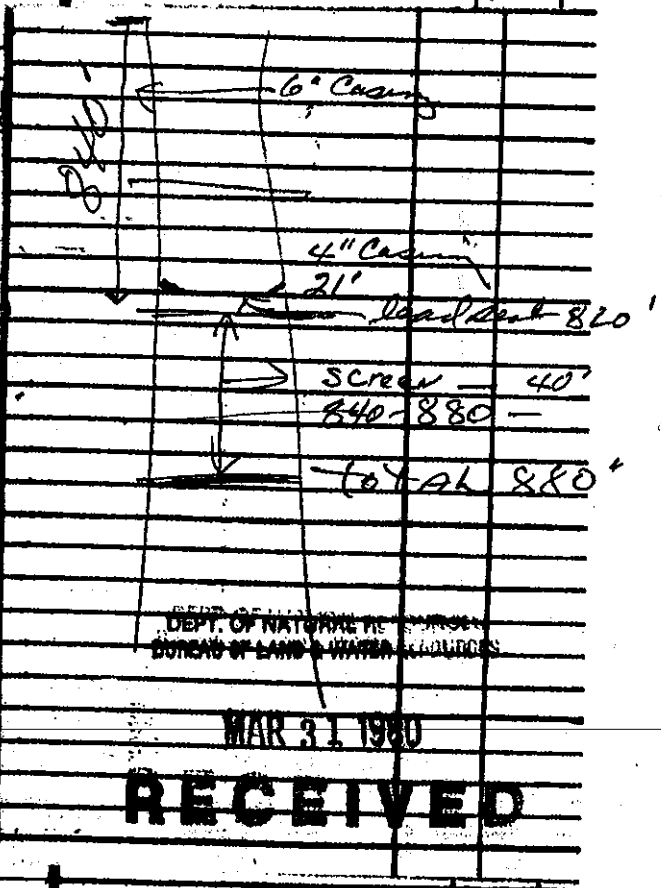

DEPT. OF NATURAL RESOURCES
BUREAU OF LAND & WATER SURVEYS

MAR 31 1980

RECEIVED

DRILLERS REMARKS:
Well flow 10-15
gpm