


LAUDERDALE
M 2038
3-6-81

MISSISSIPPI
 BOARD OF WATER COMMISSIONERS
 416 North State Street
 Jackson, Mississippi 39201

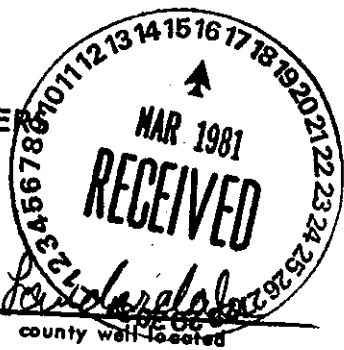

WATER WELL DRILLERS LOG
 McDonald's Hill
 firm name

3-6-81
 date well completed

county well located

LANDOWNER:

Gertrude Johnson
Rt # 5, Meridian
 (mailing address)

description of formations encountered

from to

sand	0	20
sand & clay	20	35
shale	35	45
sand & clay	45	65
shale & lignite	65	170
fine sand & shale	170	205
shale	205	222
sand & shells	222	227
rock	227	229
fine sand & shells	229	240
sandy shale	240	265
shale & lignite	265	335
shale fine sand & lignite	335	380

WELL LOCATION:


sec. 36 T. 6 N R. 5 E
3 miles S of Meridian
 (distance) (direction) (nearest town)

WELL PURPOSE: home
 (home, irrigation, municipal, industrial)

WELL COMPLETION DATA:

- (1) diameter (inches) 4"
- (2) total depth (feet) 380'
- (3) static water level (feet) 135' below top of ground
- (4) casing PVC 210'
 (material) (depth)
4" (size) If telescope see back.
- (5) screen _____
 (length) (depth to top)
 (size) (material)
- (6) pump 30 60 gpm
 (HP) (yield gpm)
F (type power)
- (7) electric log _____
 (yes or no)
 (organization running log)
- (8) how well bottom plugged Open

DEPT. OF NATURAL RESOURCES
 BUREAU OF LAND & WATER RESOURCES
 MAR 16 1981

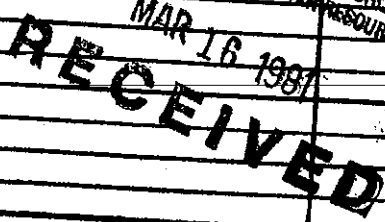

DRILLERS REMARKS: