

MISSISSIPPI BOARD OF WATER COMM.

WATER WELL DRILLERS LOG

L.A.U.D.

N5

9-9-61

Lauderdale

Date: 9-9-61, 1961, Driller: Peoples & Rutledge County, Mississippi

(Name)

(1) Owner of Land: Raymond Rauson
 (Name)
Rt. 3 Meridian
 (Address)

(2) Location: 1/4, 1/4, Sec. 27 T. 6 R. 16,
5 miles southeast of Meridian,
 (distance) (direction) (Nearest Town)

(3) Topography: Hilly
 (Hilly) (Flat) (Level)

(4) Purpose of Well: Domestic
 (Domestic Irrigation
 Municipal, Industrial, Other)

Description & Color of Materials Sand, Clay, Red Clay, Shell, etc.	Thick- ness Feet	Depth Feet
Red Sandy Clay	21	21
Red Sand	28	49
Sand Rock	1	50
Yellow sand & sandy clay	55	105
Yellow sand	126	231
Gray sandy shale & sand	21	252
Gray sandy shale	73	325
Gray sandy shale & sand	21	346
Gray sandy shale	95	441
Gray sandy shale & sand	39	480
Gray sandy shale & black	24	504
Lignite streaks		
Gray sandy shale	49	553
Rock	4	557
Gray sandy shale & black	126	683
Lignite streaks		
Gray sandy shale &	21	704
Gray & white sand & black		
Gray & white sand	74	778
Sandy shale & small sand streaks	10	788

Information upon completion of well:

(1) Diameter 4 inches.

(2) Total Depth 788 feet.

(3) Water Level 250 feet below top of ground.

(4) Cased to 296, Size 4"


(5) Screen: Size None, Length 0'

(6) Were any formations sealed against pollution?
 yes, no.

If YES depth of formation 231'

Why iron conditions in strata

Drillers Remarks:

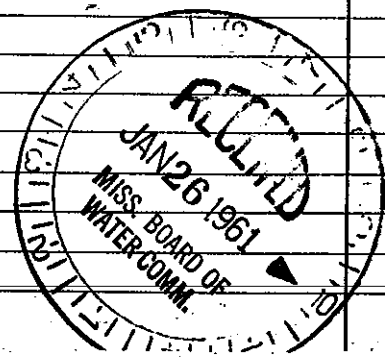

ME