

LAUD. MISSISSIPPI BOARD OF WATER COMMISSIONERS

~~SN 11~~
8-19-60

WATER WELL DRILLERS LOG

Date: Aug. 19, 1960, Driller: Terry Drilling Co. County Lauderdale
 Driller ^{Name} Robert Hall

(1) Owner of Land: <u>Eugene Robinson</u> <small>(Name)</small>	Description & Color of Materials Sand, Clay, Red Clay, Shell, etc.	Thick- ness Feet	Depth Feet
<u>Rt. 3, Meridian, Miss</u> <small>(Address)</small>	<u>Yellow sand</u>	<u>0 - 66'</u>	
	<u>gray dirt</u>	<u>66' - 88'</u>	
(2) Location: <u>36 6N 16E</u> <u>1/4</u> , <u>1/4</u> , <u>Sec. 36</u> T <u>R</u>	<u>Layer of gray dirt + sand</u>	<u>88' - 110'</u>	
<u>Long Creek Community</u>	<u>gray dirt</u>	<u>110' - 132'</u>	
<u>4</u> miles <u>Sou. East</u> , of <u>Meridian</u>	<u>gray sand</u>	<u>132' - 146'</u>	
<small>(distance) (direction) (Nearest Town)</small>			
(3) Topography: <input checked="" type="checkbox"/> <u>Hilly</u> <input type="checkbox"/> Flat <input type="checkbox"/> Level			
(4) Purpose of Well: <u>Domestic</u> <small>(Domestic Irrigation Municipal, Industrial, Other)</small>			


Information upon completion of well:

- (1) Diameter 3 inches.
- (2) Total Depth 146 feet.
- (3) Water Level 80' feet below top of ground.
- (4) Cased to 126', Size 3"
- (5) Screen: Size 2", Length 10'
- (6) Were any formations sealed against pollution?
 yes, no.

If YES depth of formation 131'

Why Surface casing set in first dirt

Drillers Remarks:

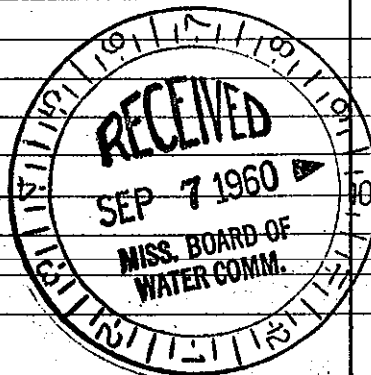

(Use Back Side)

Well No.