


Lauderdale  
N15  
7-66

MISSISSIPPI BOARD OF WATER COMMISSIONERS

WATER WELL DRILLERS LOG

Date: 7/15/, 1966, Driller: FERRY OIL CO. County LAUD  
(Name)

(1) Owner of Land: <u>Elbert Gibson</u> (Name)	Description & Color of Materials Sand, Clay, Red Clay, Shell, etc.	Thick- ness Feet	Depth Feet
<u>3rd ave. Dist. MdN.</u> (Address)	<u>SANDY - white</u>	<u>0</u>	<u>25</u>
(2) Location: <u>NE 1/4, SE 1/4, Sec. 20 T. 16 R. 6 E.</u>	<u>SHALE</u>	<u>25</u>	<u>85</u>
_____ miles <u>17</u> of <u>Meridian</u> (distance) (direction) (Nearest Town)	<u>SAND</u>	<u>85</u>	<u>140</u>
(3) Topography: _____ (Hilly) (Flat) (Level)	<u>SHALE</u>	<u>140</u>	<u>240</u>
(4) Purpose of Well: <u>COMMERCIAL</u> (Domestic Irrigation Municipal, Industrial, Other)	<u>SANDY</u>	<u>240</u>	<u>280</u>
Information upon completion of well:			
(1) Diameter <u>4</u> inches.			
(2) Total Depth <u>280</u> feet.			
(3) Water Level <u>18'</u> feet below top of ground.			
(4) Cased to <u>147'</u> , Size <u>4"</u>			
(5) Screen: Size <u>No</u> , Length _____			
(6) Were any formations sealed against pollution? _____ yes, _____ no.			
If YES depth of formation _____			
Why _____			
Drillers Remarks: _____			

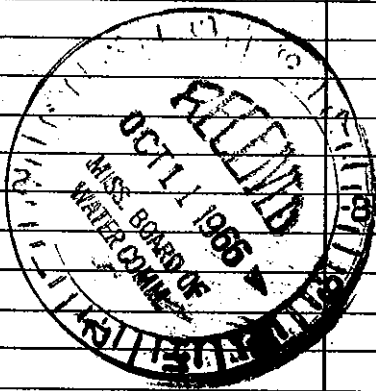

Well No.

(Use Back Side)

Mail this copy to Board of Water Commissioners 429 Miss. St. Jackson, Miss.