

Lauderdale
N16
3-67

MISSISSIPPI
BOARD OF WATER COMMISSIONERS
416 North State Street
Jackson, Mississippi 39201

WATER WELL DRILLERS LOG

date well completed 19 McDonald Hill firm name LAUDERDALE county well located

LANDOWNER: MARGARET WRIGHT

description of formations encountered	from	to
CLAY	0	20
SHALE	20	60
SANDY SHALE	60	90
SANDY SHALE	90	130
SANDY SHALE ST LIGNITE	130	165
GREY SHALE	165	285
SANDY SOFT SHALE	285	325
FINE SAND ST SHALE	325	335
	335	350
	350	410

(mailing address)


WELL LOCATION:

sec. 24 T. 16 N. R. 16 E. S. 5 W.
5 miles EAST of MERIDIAN
(distance) (direction) (nearest town)

WELL PURPOSE: HOME
(home, irrigation, municipal, industrial)

WELL COMPLETION DATA:

- (1) diameter (inches) 4" WELL
- (2) total depth (feet) 410'
- (3) static water level (feet) 230 ^{below}/_{above} top of ground.
- (4) casing BLACK, 285'
(material) (depth)
NO if telescope see back.
(size)
- (5) screen NO, NO
(length) (depth to top)
NO, NO
(size) (material)
- (6) pump 34 sub, 10
(HP) (yield gpm)
230
(type power)
- (7) electric log NO
(yes or no)
(organization running log)
- (8) how well bottom plugged OPEN

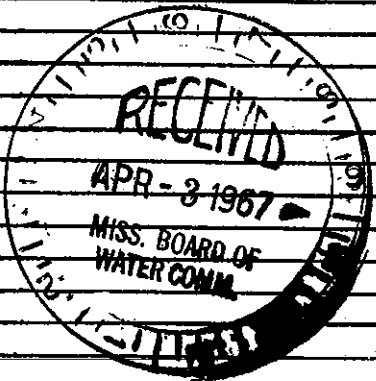

DRILLERS REMARKS: