

Lauderdale
N 17
6-67

MISSISSIPPI
BOARD OF WATER COMMISSIONERS
416 North State Street
Jackson, Mississippi 39201

WATER WELL DRILLERS LOG

date well completed 6-15-67 firm name McDONALD + HILL county well located LAUDERDALE

LANDOWNER:
TEKKY STODENMIRE
Rt 7 McN
(mailing address)

WELL LOCATION:
sec. 13 T. 6 N R. 16 E
S W
3 1/2 miles S EAST of MERIDIAN
(distance) (direction) (nearest town)

WELL PURPOSE: HOME
(home, irrigation, municipal, industrial)

WELL COMPLETION DATA:

(1) diameter (inches) 4"

(2) total depth (feet) 507

(3) static water level (feet) 285 below
top of ground.

(4) casing BLK, 334,
(material) (depth)
4 If telescope see back.
(size)


(5) screen NO, NO
(length) (depth to top)
NO, NO
(size) (material)

(6) pump 34 SUB 8
(HP) (yield gpm)
230
(type power)

(7) electric log NO
(yes or no)
NO
(organization running log)

(8) how well bottom plugged OPEN

description of formations encountered	from	to
C Sand	0	56
Clay + Sand	56	85
M TO SOFT SHALE	85	135
SANDY SHALE FINE SAND	135	170
M Sand	170	185
Brandon Shale Soft	185	284
ROCK	284	286
SOFT TO M Shale	286	317
M TO H SHALE	317	334
M TO SOFT SHALE	334	340
H TO M SHALE	340	396
SANDY SHALE TO FINE SAND	396	415
M TO SOFT SHALE	415	465
SANDY TO SOFT SHALE	465	494
ROCK	494	495
M SAND	495	507

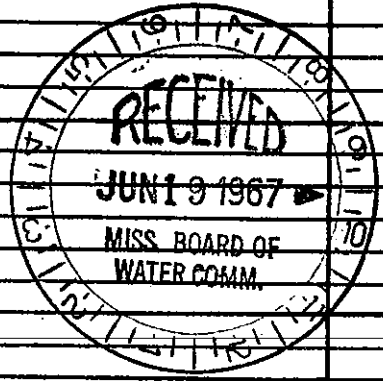

DRILLERS REMARKS: