

Lauderdale  
N 19  
11-67

MISSISSIPPI  
BOARD OF WATER COMMISSIONERS  
416 North State Street  
Jackson, Mississippi 39201


WATER WELL DRILLERS LOG

11-22-67 date well completed  
McDONALD + HILL firm name  
Lauderdale county well located

LANDOWNER: AM CURTIS  
LONG CREEK  
R#3 MERIDIAN  
(mailing address)  
WELL LOCATION:  
sec. 35 T. 6 N R. 16 E  
S W  
5 miles SEAST of MERIDIAN  
(distance) (direction) (nearest town)  
WELL PURPOSE: HOME  
(home, irrigation, municipal, industrial)

WELL COMPLETION DATA:  
(1) diameter (inches) 4" WELL  
(2) total depth (feet) 430  
(3) static water level (feet) 160' below top of ground.  
(4) casing BLACK 2 1/2"  
(material) (depth)  
4" if telescope see back.  
(size)  
(5) screen NO NO  
(length) (depth to top)  
1/2" NO  
(size) (material)  
(6) pump 3/4 10  
(HP) (yield gpm)  
230  
(type power)  
(7) electric log NO  
(yes or no)  
NO  
(organization running log)  
(8) how well bottom plugged OPEN

description of formations encountered	from	to
Clay	0	4
Sand	4	62
Clay & sand	62	102
Shale	102	149
Rock	149	150
Soft sandy shale	150	180
Shale	180	240
Soft shale	240	260
Rock	260	263
Shale	263	300
Sand	300	337
Rock	337	338
Shale	338	395
Sand	395	420

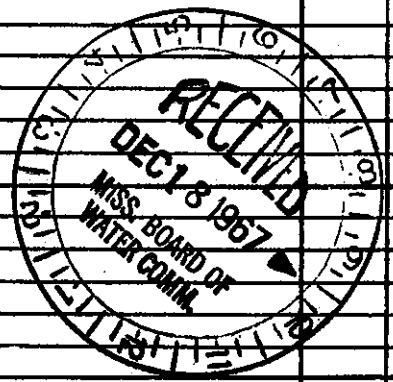

DRILLERS REMARKS: