

LAUD. MISSISSIPPI BOARD OF WATER COMMISSIONERS

N 20

6-11-65

WATER WELL DRILLERS LOG

Date: 6-11, 19 65, Driller: McDonald & Hill Inc County Anderson

(Name)

(1) Owner of Land Raymond Reece
(Name)

Rt # 7 Meiden
(Address)

(2) Location: $\frac{1}{4}$, $\frac{1}{4}$, Sec. 11 6N 16E T R
2 miles E of Meiden
(distance) (direction) (Nearest Town)

(3) Topography: (Hilly) (Flat) (Level)

(4) Purpose of Well: Domestic
(Domestic Irrigation, Municipal, Industrial, Other)

Description & Color of Materials Sand, Clay, Red Clay, Shell, etc.	Thick- ness Feet	Depth Feet
Clay	0	40
Shale	40	73
Sandy shale	73	110
Red shale	110	130
Sandy shale	130	145
Soft sandy shale	145	185
H shale sand	185	205
H shale	205	220
Sandy shale	220	225
Rock	225	226
H shale	226	335
H shale - lig	235	244
H shale - sandy	244	255
Shale	255	270
Soft shale	270	284
Sandy shale	284	288
Rock	288	293
H shale	293	350
Sandy shale	350	378
H shale	378	380


Information upon completion of well:

- (1) Diameter 4 inches.
- (2) Total Depth 380 feet.
- (3) Water Level 180 feet below top of ground.
- (4) Cased to 307, Size 4"
- (5) Screen: Size _____, Length _____
- (6) Were any formations sealed against pollution?
_____ yes, no.

If YES depth of formation _____

Why _____

Drillers Remarks: _____

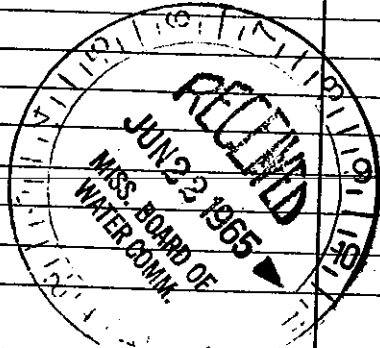

Well