

LAUD.
N 22
9-27-60


MISSISSIPPI BOARD OF WATER COMMISSIONERS

WATER WELL DRILLERS LOG

1302

Date: Sept 27, 1960, Driller: Perry Drilling Co County Lauderdale
Robert Hall (Name) - Driller

(1) Owner of Land: <u>O. K. Stewart</u> (Name)	Description & Color of Materials Sand, Clay, Red Clay, Shell, etc.	Thick- ness Feet	Depth Feet
<u>Rt. 6 Meridian, Miss</u> (Address)	<u>Yellow clay + sand shale</u>	<u>0</u>	<u>44'</u>
<u>3 6N16E</u>	<u>Gray mud + sand</u>	<u>44'</u>	<u>55'</u>
(2) Location: <u>1/4, 1/4, Sec. T. R.</u>	<u>Gray dirt</u>	<u>55'</u>	<u>65'</u>
<u>2 miles East of Meridian</u> (distance) (direction) (Nearest Town)	<u>Layer of gray mud + sand</u>	<u>65'</u>	<u>132'</u>
(3) Topography: <u>Level</u> (Hilly) (Flat) (Level)	<u>Gray mud</u>	<u>132'</u>	<u>174'</u>
(4) Purpose of Well: <u>Domestic</u> (Domestic Irrigation Municipal, Industrial, Other)	<u>Layer of gray dirt + gray sand</u>	<u>174'</u>	<u>340'</u>
Information upon completion of well:			
(1) Diameter <u>3</u> inches.			
(2) Total Depth <u>340</u> feet.			
(3) Water Level <u>100</u> feet below top of ground.			
(4) Cased to <u>170'</u> , Size <u>3"</u>			
(5) Screen: Size <u>open in bottom</u> , Length _____			
(6) Were any formations sealed against pollution?			
<u>Yes</u> , _____ no.			
If YES depth of formation _____			
Why <u>Casing set in dirt</u>			
Drillers Remarks: _____			

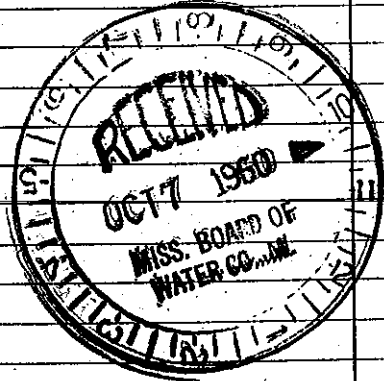

WE