

GW 1592

OK Page 7103

Lauderdale

TA N26

10-65

MISSISSIPPI BOARD OF WATER COMMISSIONERS


El log #41

WATER WELL DRILLERS LOG

Date: 10-16-, 1965, Driller: Layne-Central Co. County: Lauderdale

(Name)

| (1) Owner of Land: Long Creek Water Assn.<br>(Name)  | Description & Color of Materials<br>Sand, Clay, Red Clay, Shell, etc. | Thick-<br>ness<br>Feet | Depth<br>Feet            |
|--|---|------------------------|--------------------------|
| Meridian, Mississippi<br>(Address)   | red sandy clay  | 30                     | 30                       |
| (2) Location: SE 1/4, NW 1/4, Sec. 36 T. R. 6 N 16 E<br>miles of<br>(distance) (direction) (Nearest Town)                  | shale<br>shale-stks sand<br>hard gummy shale<br>rock                  | 128<br>32<br>160<br>3  | 158<br>190<br>350<br>353 |
| (3) Topography:<br>(Hilly) (Flat) (Level)  | shale, stks fine sand<br>fine sand, stks shale                        | 132<br>60              | 485<br>545               |
| (4) Purpose of Well: municipal<br>(Domestic Irrigation<br>Municipal, Industrial, Other)                                    | shale, stks sand<br>hard shale  | 87<br>113              | 632<br>745               |
| Information upon completion of well:   | shale, stks sand<br>sand  | 140<br>57              | 885<br>942               |
| (1) Diameter 10 inches.  | shale   | 2                      | 944                      |
| (2) Total Depth 947 feet.  | shale   | 3                      | 947                      |
| (3) Water Level 285 feet below top of ground.  |   |                        |                          |
| (4) Cased to 500', Size 10"  |   |                        |                          |
| (5) Screen: Size 6", Length 50'  |   |                        |                          |
| (6) Were any formations sealed against pollution?<br><input checked="" type="checkbox"/> yes, <input type="checkbox"/> no. |   |                        |                          |
| If YES depth of formation 500'   |   |                        |                          |
| Why required   |   |                        |                          |
| Drillers Remarks:  |   |                        |                          |

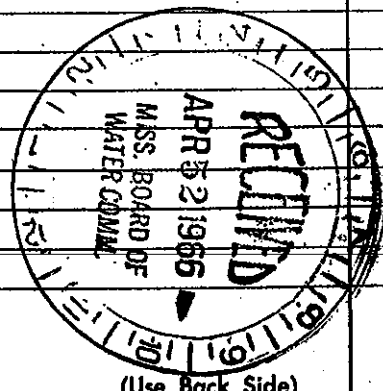

Well No.

Mail this copy to Board of Water Commissioners 429 Miss. St. Jackson, Miss