

N27
6-1-8-64

WATER WELL DRILLERS LOG

Date: 1. 8, 1964, Driller: McDonald Hill County: Lauderdale
(Name)

(1) Owner of Land:	Description & Color of Materials Sand, Clay, Red Clay, Shell, etc.	Thick- ness Feet	Depth Feet
<u>BURT SHORT</u> (Name) <u>MERIDIAN CITY</u> (Address)	<u>CLAY</u>	<u>0</u>	<u>8</u>
(2) Location: <u>1/4</u> , <u>1/4</u> , Sec. <u>21</u> <u>6N16E</u> T. R.	<u>SAND</u>	<u>8</u>	<u>18</u>
_____ miles _____ of _____	<u>SHALE ST SAND</u>	<u>18</u>	<u>30</u>
(distance) (direction) (Nearest Town)	<u>SHALE</u>	<u>30</u>	<u>180</u>
(3) Topography: _____	<u>SANDY SHALE FINE SAND</u>	<u>180</u>	<u>225</u>
(Hilly) (Flat) (Level)	<u>SOFT SHALE</u>	<u>225</u>	<u>235</u>
(4) Purpose of Well: <u>DOMESTIC</u>	<u>SAND</u>	<u>235</u>	<u>260</u>
(Domestic Irrigation Municipal, Industrial, Other)			

Information upon completion of well:

(1) Diameter: 3 7/8 inches. TEST HOLE

(2) Total Depth: 260' feet.


(3) Water Level: 14' feet below top of ground.

(4) Cased to: 127', Size 4"

(5) Screen: Size _____, Length _____

(6) Were any formations sealed against pollution?
_____ yes, _____ no.

Cannot locate RA

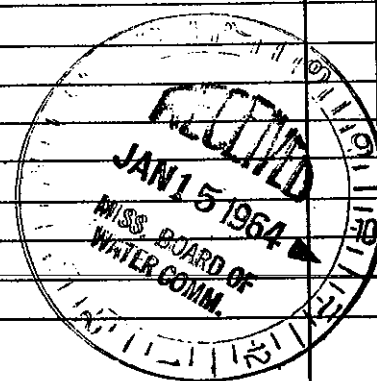

(Use Back Side)

Well No.