

LAUDERDALE
N 32
9-67

MISSISSIPPI
BOARD OF WATER COMMISSIONERS
416 North State Street
Jackson, Mississippi 39201

WATER WELL DRILLERS LOG

9-19-1967 date well completed
167 Terry Dilling firm name
Laud county well located


LANDOWNER:
Mr. Bobby Murphy
Rt 7, Meridian, Miss.
(mailing address)

WELL LOCATION:
sec. 30 T. 6 N R. 17 E
S W
6 miles SE of Meridian.
(distance) (direction) (nearest town)

WELL PURPOSE: home
(home, irrigation, municipal, industrial)

WELL COMPLETION DATA:
(1) diameter (inches) 4"
(2) total depth (feet) 445
(3) static water level (feet) 195 below top of ground.
(4) casing 300 273
(material) (depth)
(size) if telescope see back.
(5) screen
(length) (depth to top)
(size) (material)
(6) pump 1/2 5 GPM
(HP) (yield gpm)
Submerg
(type power)
(7) electric log NO
(yes or no)
(organization running log)
(8) how well bottom plugged Open
Bottom well

description of formations encountered	from	to
Yellow Clay	0	22
1" sand	22	40
Blue Clay	40	140
sand streaks	140	220
hard clay	220	350
sandy shale	350	445

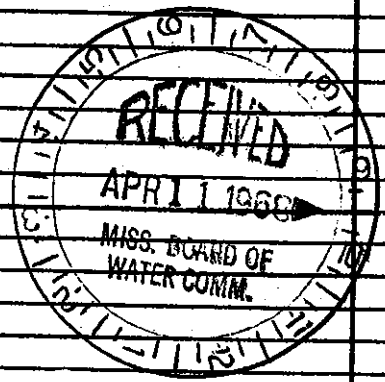

DRILLERS REMARKS: