

LAUDERDALE
N. 33
11-67

MISSISSIPPI
BOARD OF WATER COMMISSIONERS
416 North State Street
Jackson, Mississippi 39201

WATER WELL DRILLERS LOG

11-7-67 date well completed
Jerry Dillingham firm name
Laud county well located

LANDOWNER:
Michael Packing Co.
Mrs. Miss.
(mailing address)

description of formations encountered	from	to
yellow clay sand	0	30
shale streaks	30	80
hard shale	80	200
course sand	200	258

WELL LOCATION:
sec. 9 T 6 N R 16 E
in Meridian S W
(distance) miles (direction) of (nearest town)

WELL PURPOSE:
(home, irrigation, municipal, industrial)

WELL COMPLETION DATA:

(1) diameter (inches) 6"

(2) total depth (feet) 258

(3) static water level (feet) 18 below top of ground.

(4) casing 4" (material) 197' (depth)

4" If telescope see back. (size)

(5) screen 40' (length) 218' (depth to top)

4" (size) Stainless Steel (material)


(6) pump 10 (HP) 150 (yield gpm)

Submerge (type power)

(7) electric log No (yes or no)

(organization running log)

(8) how well bottom plugged Wash

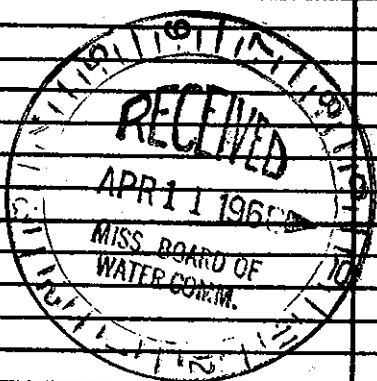

DRILLERS REMARKS: very little draw down