

MISSISSIPPI BOARD OF WATER COMMISSIONERS

LAUD.
N58
7-6-60

WATER WELL DRILLERS LOG

N 303
CODED

Date: 7-6, 1960, Driller: M. Donald & Hill, Jr. County W. Lauderdale
(Name)


(1) Owner of Land: Juanita Tanager
(Name)
Rt # 7, Meridian, Miss
(Address)
(2) Location: 15 616 616,
3 miles East of Meridian
(distance) (direction) (Nearest Town)
(3) Topography: Hilly
(Hilly) (Flat) (Level)
(4) Purpose of Well: Domestic
(Domestic Irrigation, Municipal, Industrial, Other)

Description & Color of Materials Sand, Clay, Red Clay, Shell, etc.	Thick- ness Feet	Depth Feet
<u>Sand & Sandy Clay</u>	<u>0</u>	<u>35</u>
<u>Lignite</u>	<u>25</u>	<u>40</u>
<u>manl.</u>	<u>40</u>	<u>125</u>
<u>Coarse Sand</u>	<u>125</u>	<u>135</u>
<u>manl.</u>	<u>135</u>	<u>150</u>
<u>Sands streaks</u>	<u>150</u>	<u>155</u>
<u>Rock</u>	<u>155</u>	<u>160</u>
<u>manl.</u>	<u>160</u>	<u>220</u>
<u>Sandy manl & Sand shale</u>	<u>220</u>	<u>295</u>
<u>manl.</u>	<u>295</u>	<u>320</u>

Information upon completion of well:

(1) Diameter 3 inches.
(2) Total Depth 320 feet.
(3) Water Level 145 feet below top of ground.
(4) Cased to 168, Size 3"
(5) Screen: Size none, Length ✓
(6) Were any formations sealed against pollution?
no yes, ✓ no.
If YES depth of formation _____
Why _____
Drillers Remarks: _____

CODED

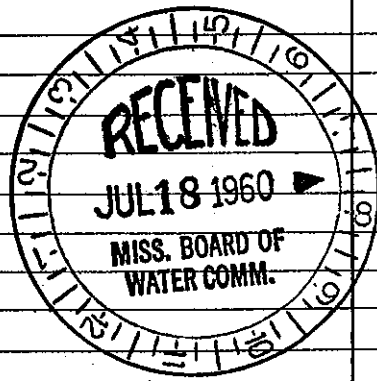

Well No.

(Use Back Side)