

MISSISSIPPI BOARD OF WATER COMMISSIONERS

**CODED**

**WATER WELL DRILLERS LOG**

DAVD.  
N 59  
9-3-60  
Date: 9/3

1960, Driller: McDonald + Hill County: Lauderdale  
(Name)


(1) Owner of Land: Mich. West, Tom & Selma  
(Name)  
Tom & Selma Davis - Meridian, Miss.  
(Address)  
(2) Location: 20 1/2 R / 6  
1/4, 1/4, Sec.  
6 miles 6 of 6  
(distance) (direction) (Nearest Town)  
(3) Topography: Flat  
(Hilly) (Flat) (Level)  
(4) Purpose of Well: Domestic  
(Domestic Irrigation, Municipal, Industrial, Other)

Description & Color of Materials Sand, Clay, Red Clay, Shell, etc.	Thick- ness Feet	Depth Feet
Clay	0	20
S. Sand	20	27
marl	27	70
Sandy marl	70	80
marl	80	120
Sandy shale	120	170

Information upon completion of well:

(1) Diameter 2 inches.  
(2) Total Depth 170 feet.  
(3) Water Level 10 feet below top of ground.  
(4) Cased to 105, Size 2"  
(5) Screen: Size \_\_\_\_\_, Length \_\_\_\_\_  
(6) Were any formations sealed against pollution?  
\_\_\_\_\_ yes,  no.

**CODED**

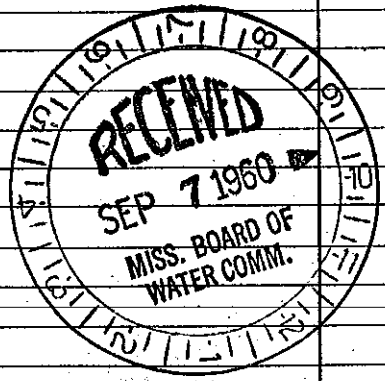

If YES depth of formation \_\_\_\_\_  
Why \_\_\_\_\_  
Drillers Remarks: \_\_\_\_\_

Well No.

(Use Back Side)