

MISSISSIPPI BOARD OF WATER COMMISSIONERS

LAUD.
N 60
3-25-61

WATER WELL DRILLERS **CODED**

Date: 3.25, 1961, Driller: McDONALD HILL County: LAUDERDALE

(Name)

(1) Owner of Land: DAN HOLLINGWORTH, JR.
(Name)
R# 7 MERIDIAN
(Address)
(2) Location: 1/4, 14 1/4, Sec. 6 T 16 R
5 miles EAST of MERIDIAN.
(distance) (direction) (Nearest Town)
(3) Topography: X
(Hilly) (Flat) (Level)
(4) Purpose of Well: DOMESTIC
(Domestic Irrigation, Municipal, Industrial, Other)

| Description & Color of Materials Sand, Clay, Red Clay, Shell, etc. | Thick- ness Feet | Depth Feet |
|---|------------------------|---------------|
| CLAY | 0 | 10 |
| SAND | 10 | 20 |
| BLUE SHALE | 20 | 20 |
| SANDY SHALE | 80 | 135 |
| FINE SAND | 135 | 141 |
| MED SHALE | 141 | 175 |
| SOFT SHALE | 175 | 195 |
| SANDY SHALE | 195 | 205 |
| ROCK | 205 | 206 |
| SOFT SHALE | 206 | 210 |
| HARD SHALE | 210 | 225 |
| SHALE | 225 | 247 |
| ROCK | 247 | 247 1/2 |
| FINE SAND | 247 1/2 | 256 |
| SHALE | 256 | 270 |
| SANDY SHALE | 270 | 295 |
| SHALE | 295 | 330 |
| SAND | 330 | 350 |


Information upon completion of well:

(1) Diameter: 3" inches.
(2) Total Depth: 350' feet.
(3) Water Level: 145' feet below top of ground.
(4) Cased to 170', Size 3"
(5) Screen: Size _____, Length _____
(6) Were any formations sealed against pollution?
_____ yes, _____ no.

If YES depth of formation _____

Why _____

Drillers Remarks: _____

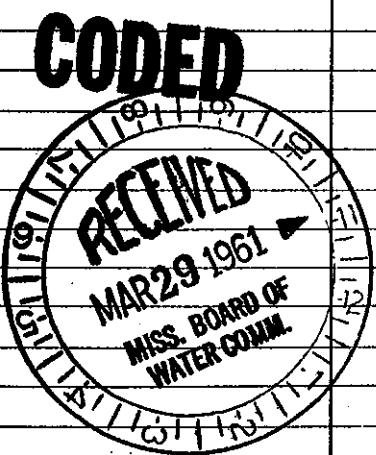

(Use Back Side)

Well No.

Mail this copy to Board of Water Commissioners 429 Miss. St. Jackson, Miss.