

L.A.P.D.
N63
8-11-61

WATER WELL DRILLERS LOG

CODED

Date: 8/11, 1961, Driller: McDonald & Dell County Lauderdale
(Name)

(1) Owner of Land: Floyd Worth
(Name)
Rt 6 mdr
(Address)

(2) Location: 1/4, 13 6 16
_____ miles _____ of _____
(distance) (direction) (Nearest Town)

(3) Topography: Hilly
(Hilly) (Flat) (Level)

(4) Purpose of Well: Domestic
(Domestic Irrigation
Municipal, Industrial, Other)

Description & Color of Materials Sand, Clay, Red Clay, Shell, etc.	Thick- ness Feet	Depth Feet
clay	0	16
sandy	16	41
marl	41	88
c sand	88	94
marl	94	120
shells + sand	120	128
marl + sand str.	128	140
soft marl	140	155
marl	155	170
marl + lignite str.	170	195
sandy marl	195	203
blue marl (goaf)	203	210
sandy marl	210	250
brandy marl	250	265
medium sand	265	270
soft marl, sandy str.	270	280
hard marl	280	283
fine sand	283	290
soft marl	290	310
hard marl	310	320

Information upon completion of well:

(1) Diameter 3 inches.

(2) Total Depth 320 feet.

(3) Water Level 200 feet below top of ground.

(4) Cased to 205, Size 3 inch

(5) Screen: Size _____, Length _____.


(6) Were any formations sealed against pollution?
_____ yes, no.

If YES depth of formation _____

Why _____

Drillers Remarks: _____

CODED

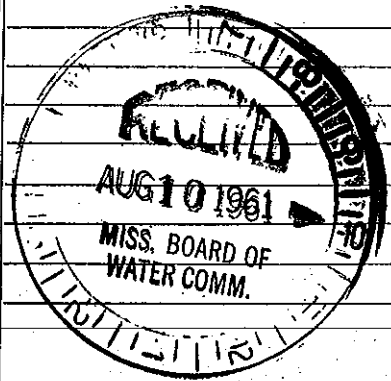

(Use Back Side)

Well No

Mail this copy to Board of Water Commissioners 429 Miss. St. Jackson, Miss