

LAUD.

MISSISSIPPI BOARD OF WATER COMMISSIONERS

N64
9-20-61

WATER WELL DRILLERS LOG **CODED**

Date: 9.20, 1961, Driller: McDONALD HILL County: FAULKNER
(Name)

(1) Owner of Land: JAMES BEALE
(Name)

Rt 6 Meridian
(Address)

(2) Location: 24 6 16
 ¼, ¼, Sec. T R

5 miles EAST, Meridian
(distance) (direction) (Nearest Town)

(3) Topography: X
(Hilly) (Flat) (Level)

(4) Purpose of Well: DOMESTIC
(Domestic Irrigation
Municipal, Industrial, Other)

Description & Color of Materials Sand, Clay, Red Clay, Shell, etc.	Thick- ness Feet	Depth Feet
CLAY	0	10
SAND ST CLAY	10	90
BLUE SHALE	90	95
SAND	95	108
SHALE	108	180
SANDY SHALE	180	220
FINE SAND	220	232
SHALE	232	312
ROCK	312	314
SOFT SHALE	314	352
SANDY SHALE	352	366
ROCK	366	370
SHALE	370	430
SANDY SHALE	430	460
FINE SAND ST SHALE	460	480

Information upon completion of well:

(1) Diameter 4" inches.

(2) Total Depth 480' feet.

(3) Water Level 285 feet below top of ground.

(4) Cased to 275, Size 4"

(5) Screen: Size _____, Length _____.


(6) Were any formations sealed against pollution?
_____ yes, _____ no.

If YES depth of formation _____

Why _____

Drillers Remarks: _____

CODED

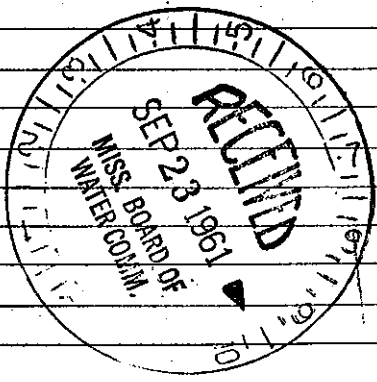

Well No.

(Use Back Side)

Mail this copy to Board of Water Commissioners 429 Miss. St. Jackson, Miss.