

LAUD.

MISSISSIPPI BOARD OF WATER COMMISSIONERS

N 65

WATER WELL DRILLERS LOG

CODED

7-28-62

Date: 7-28, 1962, Driller: McDonald & Hill County: Lauderdale

(Name)

	Description & Color of Materials Sand, Clay, Red Clay, Shell, etc.	Thick- ness Feet	Depth Feet
(1) Owner of Land: <u>Jim Creel</u> (Name)	<u>Clay</u>	<u>0</u>	<u>10</u>
<u>Rt #6 Meridian</u> (Address)	<u>Shale</u>	<u>10</u>	<u>20</u>
(2) Location: <u>3/4</u> , <u>3/4</u> , Sec. <u>6</u> , T. <u>16</u> , R. <u>1</u>	<u>Sand st. Clay</u>	<u>20</u>	<u>40</u>
<u>6</u> miles <u>East</u> , of <u>Meridian</u> (distance) (direction) (Nearest Town)	<u>Sand</u>	<u>40</u>	<u>60</u>
(3) Topography: _____ (Hilly) (Flat) (Level)	<u>Shale</u>	<u>60</u>	<u>152</u>
(4) Purpose of Well: <u>Domestic</u> (Domestic Irrigation, Municipal, Industrial, Other)	<u>Soft Shale</u>	<u>152</u>	<u>190</u>
	<u>Shale</u>	<u>190</u>	<u>210</u>
	<u>Shale</u>	<u>210</u>	<u>250</u>
	<u>Sandy Shale</u>	<u>250</u>	<u>270</u>
	<u>Shale</u>	<u>270</u>	<u>290</u>
	<u>Sand Fine Sand</u>	<u>290</u>	<u>330</u>

Information upon completion of well:

(1) Diameter 4 inches.

(2) Total Depth 330 feet.

(3) Water Level 144 feet below top of ground.

(4) Cased to 210, Size 4"

(5) Screen: Size ~~XXXX~~, Length ~~XXXX~~

(6) Were any formations sealed against pollution?


yes, no,

If YES depth of formation _____

Why _____

Drillers Remarks: _____

CODED

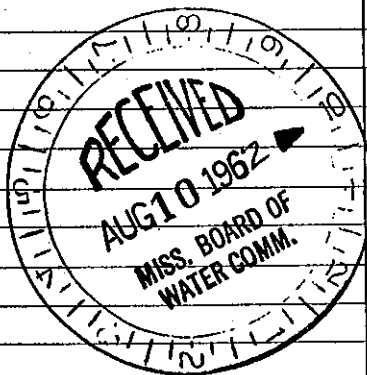

Well No.

(Use Back Side)

Mail this copy to Board of Water Commissioners 429 Miss. St. Jackson, Miss.