

LAUD. MISSISSIPPI BOARD OF WATER COMMISSIONERS

N67
10-25-62

WATER WELL DRILLERS LOG **CODED**

Date: 10-25, 1962, Driller: MCDONALD & TYLL, MERIDIAN, MISSISSIPPI
P. O. Box 81
(Name)

(1) Owner of Land: R.J. Posey
(Name)
Rt # 6 Meridian
(Address)

(2) Location: $\frac{1}{4}$, 13 Sec. 6 T. 16 R.
6 miles E, of Meridian
(distance) (direction) (Nearest Town)

(3) Topography: (Hilly) (Flat) (Level)

(4) Purpose of Well: Domestic
(Domestic Irrigation, Municipal, Industrial, Other)

Description & Color of Materials Sand, Clay, Red Clay, Shell, etc.	Thick- ness Feet	Depth Feet
Clay	0	20
Shale	20	60
Sandy Shale	60	105
Shale	105	260
Sandy	260	280
Sandy Shale	280	310

Information upon completion of well:

(1) Diameter 3 inches.

(2) Total Depth 310 feet.

(3) Water Level 200 feet below top of ground.

(4) Cased to 231, Size 3.

(5) Screen: Size _____, Length _____.


(6) Were any formations sealed against pollution?
_____ yes, _____ no.

If YES, depth of formation _____

Why _____

Drillers Remarks: _____

CODED

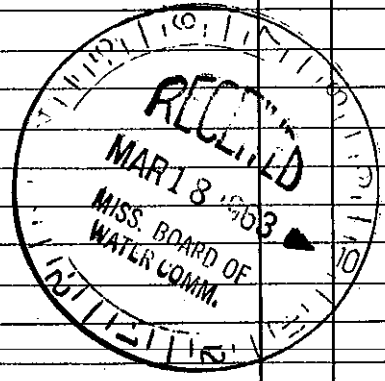

Well No.

(Use Back Side)

Mail this copy to Board of Water Commissioners 429 Miss. St. Jackson, Miss.