

LAUD. MISSISSIPPI BOARD OF WATER COMMISSIONERS

WATER WELL DRILLERS LOG

**CODED**

N68  
1-17-63

Date: 1-17, 1963, Driller: McDonald Hill Paulsdale  
(Name)

(1) Owner of Land: W. C. WILKINSON  
(Name)  
Rt 16 N 15 Sec 6 T 16 R  
(Address)

(2) Location: 1/4, 1/4, Sec. 6 T. 16 R.  
miles \_\_\_\_\_ of \_\_\_\_\_  
(distance) (direction) (Nearest Town)

(3) Topography: X  
(Hilly) (Flat) (Level)

(4) Purpose of Well: DOMESTIC  
(Domestic Irrigation, Municipal, Industrial, Other)

Description & Color of Materials Sand, Clay, Red Clay, Shell, etc.	Thick- ness Feet	Depth Feet
	0	25
SHALE	25	45
CLAY SAND	45	75
SHALE	75	190
SANDY SHALE	190	240
SHALE	240	260
SOFT SANDY SHALE	260	300
SHALE	300	350
SANDY SHALE	350	400
FINE SAND	400	495

Information upon completion of well:

(1) Diameter 3 1/2 inches.

(2) Total Depth 445 feet.

(3) Water Level 190' feet below top of ground.

(4) Cased to 254', Size 4"

(5) Screen: Size \_\_\_\_\_, Length \_\_\_\_\_.


(6) Were any formations sealed against pollution?  
\_\_\_\_\_ yes, \_\_\_\_\_ no.

If YES depth of formation \_\_\_\_\_

Why \_\_\_\_\_

Drillers Remarks: \_\_\_\_\_

**CODED**

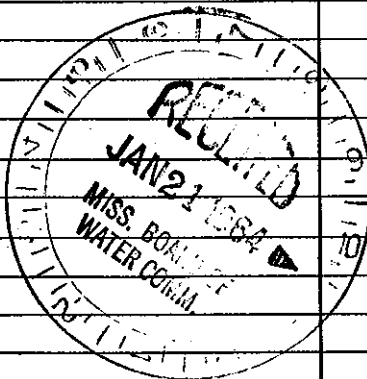

Well No.

(Use Back Side)

Mail this copy to Board of Water Commissioners 429 Miss. St. Jackson, Miss.