

LAUD.

MISSISSIPPI BOARD OF WATER COMMISSIONERS

N69

WATER WELL DRILLERS LOG **CODED**

2-21-63

Date: 2-21, 1963, Driller: McDONALD & HILL, Inc. County Lauderdale
P. (Name) POX 81

(1) Owner of Land: <u>Clyde Pickett</u> (Name)	Description & Color of Materials Sand, Clay, Red Clay, Shell, etc.	Thick- ness Feet	Depth Feet
<u>Rt. #3, Meridian, Miss</u> (Address)	<u>Clay</u>	<u>0</u>	<u>18</u>
(2) Location: <u>1/4, 34, Sec. 6, T. 16</u>	<u>Sandy clay & sand</u>	<u>18</u>	<u>30</u>
<u>8</u> miles <u>S.E.</u> of <u>Meridian</u> (distance) (direction) (Nearest Town)	<u>yellow</u>	<u>30</u>	<u>40</u>
(3) Topography: <input checked="" type="checkbox"/> (Hilly) <input type="checkbox"/> (Flat) <input type="checkbox"/> (Level)	<u>clay</u>	<u>40</u>	<u>60</u>
(4) Purpose of Well: <u>Domestic</u> (Domestic Irrigation, Municipal, Industrial, Other)	<u>Sand</u>	<u>60</u>	<u>90</u>
	<u>Sand w/ yellow clay</u>	<u>90</u>	<u>145</u>
	<u>Sand w/ rock str.</u>	<u>145</u>	<u>148</u>
	<u>Sand</u>	<u>148</u>	<u>153</u>
	<u>B. Shale</u>	<u>153</u>	<u>156</u>
	<u>Sand</u>	<u>156</u>	<u>160</u>

Information upon completion of well:


- (1) Diameter 2 inches.
- (2) Total Depth 145 feet.
- (3) Water Level 145 feet below top of ground.
- (4) Cased to 143, Size 2"
- (5) Screen: Size 2", Length 3'
- (6) Were any formations sealed against pollution?
no

If YES depth of formation _____

Why _____

Drillers Remarks: _____

CODED

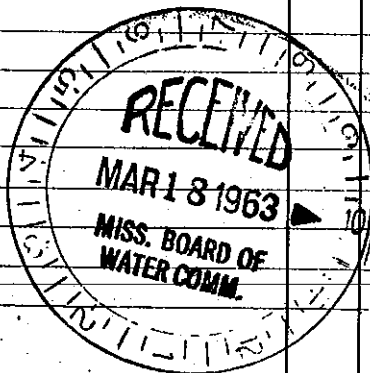

Well No. _____

(Use Back Side)

Retain this copy for your office files.