

LAUD.

N 74

7-22-66

MISSISSIPPI BOARD OF WATER COMMISSIONERS

WATER WELL DRILLERS LOG

CODED


Date: 7-22, 1966, Driller: Mc DONALD Y HILLS County LAUD.

(1) Owner of Land: Alan Lloyd
(2) Location: 1/4, 24 Sec. C-16, 8 miles East of Mendocino
(3) Topography: Hilly
(4) Purpose of Well: Domestic

Table with 4 columns: Description & Color of Materials, Thickness Feet, Depth Feet. Rows include CLAY, SHALE, SANDY, ROCK, SOFT TO M SHALE, M TO SOFT SHALE, H SHALE, M TO H SHALE, ROCK STR, H SHALE, SOFT SHALE, SANDY, M TO H SHALE, SAND LIGNITE, SHALE, SOFT TO SANDY SHALE, SHALE, SOFT TO SANDY SHALE, M SHALE, SANDY SHALE, SOFT SHALE.

Information upon completion of well:
(1) Diameter 2 inches.
(2) Total Depth 400 feet.
(3) Water Level 245 feet below top of ground.
(4) Cased to 270, Size 2
(5) Screen: Size, Length
(6) Were any formations sealed against pollution?
If YES depth of formation
Why
Drillers Remarks:
Yield in gpm:
Size pump:
Type power:

CODED

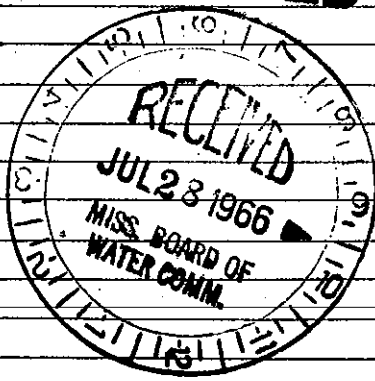

Retain this copy for your office files.