

LAUDERDALE

N 112

11-25-74

MISSISSIPPI  
BOARD OF WATER COMMISSIONERS  
416 North State Street  
Jackson, Mississippi 39201 CODED

WATER WELL DRILLERS LOG

11-25

date well completed

19 74 McDonald & Hill Inc

firm name

Lauderdale

county well located

LANDOWNER: Edd Griggs

(mailing address)

WELL LOCATION:

sec. 24 T 6 N R 16 E

2 miles east of Mendon  
(distance) (direction) (nearest town)

WELL PURPOSE:

home  
(home, irrigation, municipal, industrial)

WELL COMPLETION DATA:


- (1) diameter (inches) 4
- (2) total depth (feet) 480
- (3) static water level (feet) 250 below top of ground
- (4) casing 4" PVC 340'  
(material) (depth)  
3/4" if telescope see back.  
(size)
- (5) screen NO  
(length) (depth to top)  
(size) (material)
- (6) pump (HP) (yield gpm)  
(type power)
- (7) electric log NO  
(yes or no)  
(organization running log)
- (8) how well bottom plugged open end

description of formations encountered

from to

Coarse sand	0	10
Shale	10	20
Clay + sand	20	50
Shale	50	100
st fine sand	100	110
Shale	110	235
Rock	235	237
Shale, Lignite st	237	290
st sand/sh shale	290	300
Rock	300	301
Shale	301	356
st sandy shale	356	380
Shale	380	420
st sandy shale	420	448
st coarse sand	448	480

DRILLERS REMARKS: none

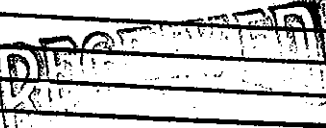

NOV 29 1974

MISS. Bd. OF WATER COMM