


Lauderdale
 N 2002
 10-30-75

MISSISSIPPI
 BOARD OF WATER COMMISSIONERS
 416 North State Street
 Jackson, Mississippi 39201

WATER WELL DRILLERS LOG

10,30,75 19 McDONALD + HILL LAUDERDALE
 date well completed firm name county well located

LANDOWNER:	description of formations encountered	from	to
<u>C. R. DATTERSON</u>	<u>Clay sand</u>	<u>0</u>	<u>18</u>
<u>Rt #1, Meridian miss</u> (mailing address)	<u>sand</u>	<u>18</u>	<u>45</u>
WELL LOCATION: sec <u>32</u> T. <u>60N</u> R. <u>10E</u> <u>13P</u> <u>3</u> miles <u>SOUTH</u> of <u>MERIDIAN</u> (distance) (direction) (nearest town)	<u>Shale & Rock</u>	<u>45</u>	<u>140</u>
WELL PURPOSE: (home, Irrigation, municipal, Industrial) <u>HOME</u>	<u>sand</u>	<u>140</u>	<u>190</u>
WELL COMPLETION DATA: (1) diameter (inches) <u>4"</u>	<u>Soft sand</u>	<u>190</u>	<u>240</u>
(2) total depth (feet) <u>640'</u>	<u>shale</u>	<u>240</u>	<u>330</u>
(3) static water level (feet) <u>302'</u> below top of ground.	<u>sand</u>	<u>330</u>	<u>390</u>
(4) casing <u>PVC</u> <u>410'</u> (material) (depth)	<u>shale</u>	<u>390</u>	<u>496</u>
<u>4"</u> if telescope see back. (size)	<u>Sandy shale</u>	<u>496</u>	<u>542</u>
(5) screen _____ (length) (depth to top)	<u>Rock</u>	<u>542</u>	<u>543</u>
(size) (material)	<u>fine sand & shells</u>	<u>543</u>	<u>640</u>
(6) pump <u>1 506</u> <u>8</u> (HP) (yield gpm)			
<u>E</u> (type power)			
(7) electric log _____ (yes or no)			
(organization running log)			
(8) how well bottom plugged <u>OPEN</u>			
DRILLERS REMARKS:			

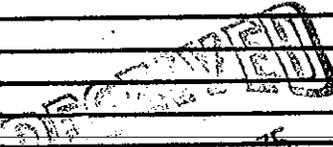

NOV 10 1975

MISS. BD. OF WATER COMM.