

LAUDERDALE
N 2044

MISSISSIPPI
BOARD OF WATER COMMISSIONERS
416 North State Street
Jackson, Mississippi 39201

6-5-80

WATER WELL DRILLERS LOG

6/5/80

19 Jerry Drilling Co.

Laud

date well completed

firm name

county well located


LANDOWNER:
Sammy Boone
P.O. Box 849, Mendenhall, Miss
(mailing address)

description of formations encountered	from	to
<u>sand & clay</u>	<u>0</u>	<u>60</u>
<u>clay</u>	<u>60</u>	<u>150</u>
<u>sandy</u>	<u>150</u>	<u>250</u>
<u>clay</u>	<u>250</u>	<u>350</u>
<u>sand</u>	<u>350</u>	<u>400</u>

WELL LOCATION:
sec. 9 T. 6 N. R. 16 E
S W
1 miles E of MDH
(distance) (direction) (nearest town)

WELL PURPOSE:
(home, irrigation, municipal, industrial)

- WELL COMPLETION DATA:
- (1) diameter (inches) 4"
 - (2) total depth (feet) 400
 - (3) static water level (feet) 100 below top of ground.
 - (4) casing PVC 400
(material) (depth)
 - (size) If telescope see back.
 - (5) screen _____
(length) (depth to top)
 - (size) (material)
 - (6) pump 3/4 7
(HP) (yield gpm)
 - Sub
(type power)
 - (7) electric log _____
(yes or no)
 - (organization running log)
 - (8) how well bottom plugged open

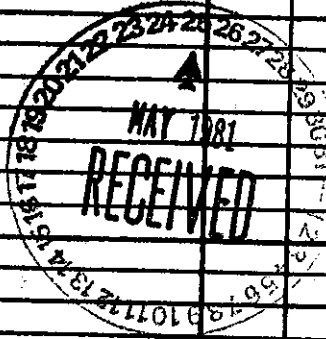

DRILLERS REMARKS: