

LAUDERDALE
N 7045
6-5-80

MISSISSIPPI
 BOARD OF WATER COMMISSIONERS
 416 North State Street
 Jackson, Mississippi 39201

WATER WELL DRILLERS LOG

6/5/80 19 Jerry Drilling Co Laud
 date well completed firm name county well located


LANDOWNER:
Marshall Alexander
Rt 10, Mdn. Miss.
 (mailing address)

description of formations encountered	from to	
	feet	feet
<u>sandy clay</u>	<u>0</u>	<u>110</u>
<u>clay</u>	<u>110</u>	<u>220</u>
<u>sandy clay</u>	<u>220</u>	<u>350</u>
<u>clay</u>	<u>350</u>	<u>400</u>
<u>clay + mud streak</u>	<u>400</u>	<u>470</u>

WELL LOCATION:
 sec. 12 T. 6 N R. 16 E
 S W
5 miles SE of Mdn.
 (distance) (direction) (nearest town)

WELL PURPOSE:
 (home, irrigation, municipal, industrial)

- WELL COMPLETION DATA:
- (1) diameter (inches) 4"
 - (2) total depth (feet) 470
 - (3) static water level (feet) 300 below top of ground.
 - (4) casing PVC 380
 (material) (depth)
 (size) if telescope see back.
 - (5) screen _____
 (length) (depth to top)
 (size) (material)
 - (6) pump 1 6
 (HP) (yield gpm)
Sub
 (type power)
 - (7) electric log _____
 (yes or no)
 (organization running log)
 - (8) how well bottom plugged open

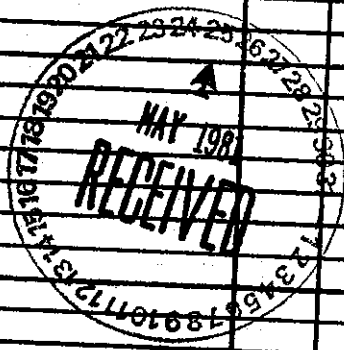

DRILLERS REMARKS: