

LAUDERDALE
 N
 2046
 3-31-81

MISSISSIPPI
 BOARD OF WATER COMMISSIONERS
 416 North State Street
 Jackson, Mississippi 39201

WATER WELL DRILLERS LOG

9/31/81 date well completed 1981 firm name Jerry Drilling Land county well located

LANDOWNER:	description of formations encountered	from	to
James Cleavers	yellow clay	0	12
2306 9th Main Min	Sand	12	50
(mailing address)	clay	50	200
	sandy	200	260

WELL LOCATION:
 sec. 18 T. 6 N R. 16 E
 2 miles (distance) of (direction) (nearest town)

WELL PURPOSE: Clearing Plant
 (home, irrigation, municipal, industrial)

WELL COMPLETION DATA:

(1) diameter (inches) 4"

(2) total depth (feet) 260

(3) static water level (feet) 36 below above top of ground

(4) casing PVC 160
 (material) (depth)

(size) if telescope see back.

(5) screen (length) (depth to top)

(size) (material)


(6) pump 1/2 HP 10 (HP) (yield gpm)

Sul (type power)

(7) electric log (yes or no)

(organization running log)

(8) how well bottom plugged open

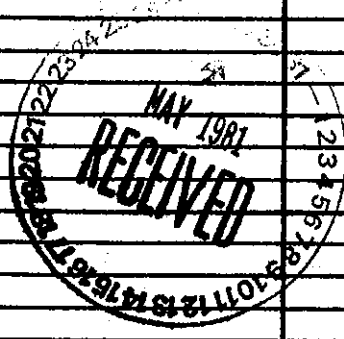

DRILLERS REMARKS: