


Lauderdale
 03
 8-66

MISSISSIPPI BOARD OF WATER COMMISSIONERS

WATER WELL DRILLERS LOG

Date: Aug 5, 1966 Driller: TERRY County LAUD.
(Name)

		Description & Color of Materials Sand, Clay, Red Clay, Shell, etc.	Thick- ness Feet	Depth Feet
(1) Owner of Land: <u>PURE OIL CO</u> <small>(Name)</small>		<u>0-55' yellow sand</u>	<u>55</u>	<u>55</u>
<u>BIRMINGHAM, ALA.</u> <small>(Address)</small>		<u>55-110' shale</u>	<u>55</u>	<u>110</u>
(2) Location: <u>NW 1/4, SE 1/4, Sec. 6 T16N R17E</u>		<u>110-170 - sandy shale</u>	<u>60</u>	<u>170</u>
<u>7</u> miles <u>E</u> , of <u>MDN.</u> <small>(distance) (direction) (Nearest Town)</small>		<u>170-220 - sand -</u>	<u>50</u>	<u>220</u>
(3) Topography: <input checked="" type="radio"/> (Hilly) <input type="radio"/> (Flat) <input type="radio"/> (Level)		<u>220-340 - hard shale</u>	<u>120</u>	<u>340</u>
(4) Purpose of Well: <u>COMMERCIAL</u> <small>(Domestic Irrigation Municipal, Industrial, Other)</small>		<u>340-440 - sand</u>	<u>100</u>	<u>440</u>
		<u>440-450 - blue dirt.</u>	<u>10</u>	<u>450</u>
Information upon completion of well:				
(1) Diameter <u>4</u> inches.				
(2) Total Depth <u>450</u> feet.				
(3) Water Level <u>202</u> feet below top of ground.				
(4) Cased to <u>315'</u> , Size <u>4"</u>				
(5) Screen: Size <u>2 1/2"</u> , Length <u>30'</u>				
(6) Were any formations sealed against pollution? <input type="checkbox"/> yes, <input type="checkbox"/> no.				
If YES depth of formation _____				
Why _____				
Drillers Remarks: <u>2 Wells pumps</u> <u>600 gpm</u>				

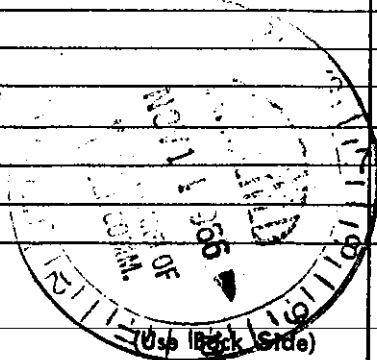

Well No.

Retain this copy for your office files.