

LAUD.

04

3-20-61

WATER WELL DRILLERS LOG

0 300

Date: 3-20, 1961, Driller: Leeper Rutledge

Lauderdale County


(1) Owner of Land: W. M. Rutledge, Jr.
(Name)
Rt 7, Meridian, Miss.
(Address)
29 6N NE
(2) Location: 1/4, 1/4, Sec. T. R.
1 miles west of Meridian
(distance) (direction) (Nearest Town)
(3) Topography: Hilly
(Hilly) (Flat) (Level)
(4) Purpose of Well: Domestic
(Domestic Irrigation, Municipal, Industrial, Other)

Description & Color of Materials Sand, Clay, Red Clay, Shell, etc.	Thick- ness Feet	Depth Feet
<u>yellow sandy clay & sand</u>	<u>35</u>	<u>35</u>
<u>blue shale</u>	<u>39</u>	<u>74</u>
<u>soft limestone</u>	<u>2</u>	<u>76</u>
<u>gray sandy shale</u>	<u>64</u>	<u>140</u>
<u>fine soft gray sand</u>	<u>26</u>	<u>166</u>
<u>hard rock</u>	<u>2</u>	<u>168</u>
<u>gray sandy shale & sand</u>	<u>58</u>	<u>226</u>
<u>sand streaks</u>	<u>3</u>	<u>229</u>
<u>lighter hard gray shale</u>	<u>38</u>	<u>267</u>
<u>gray sandy shale & sand</u>	<u>218</u>	<u>485</u>
<u>gray sand streaks</u>		

Information upon completion of well:

(1) Diameter 4 inches.
(2) Total Depth 468 feet.
(3) Water Level 130 feet below top of ground.
(4) Cased to 245', Size 4"
(5) Screen: Size _____, Length _____
(6) Were any formations sealed against pollution?
_____ yes, no.

If YES depth of formation _____
Why _____
Drillers Remarks: _____

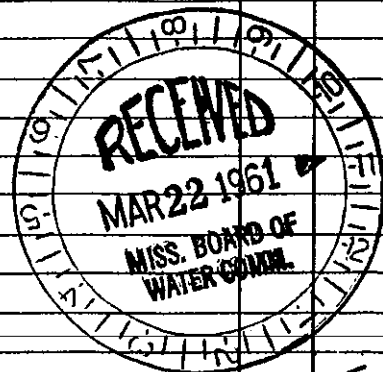

Well