


LAUD. MISSISSIPPI BOARD OF WATER COMMISSIONERS

05
4-4-64

WATER WELL DRILLERS LOG

Date: April 4, 1964, Driller: Bob Williams County Lauderdale
(Name)

	Description & Color of Materials Sand, Clay, Red Clay, Shell, etc.	Thick- ness Feet	Depth Feet
(1) Owner of Land: Doyle Thornton (Name) Rt. 6, Meridian (Address)	Red sand Blue Clay Gray sand	42 18 47	1-42 42-60 60-107
(2) Location: NE 1/4, NW 1/4, Sec. 30 T. 6 N. R. 17 E. 8 miles East of Meridian (distance) (direction) (Nearest Town)			
(3) Topography: Hilly (Hilly) (Flat) (Level)			
(4) Purpose of Well: Domestic (Domestic Irrigation Municipal, Industrial, Other)			
Information upon completion of well:			
(1) Diameter 2 inches.			
(2) Total Depth 107 feet.			
(3) Water Level 58 feet below top of ground.			
(4) Cased to 74, Size 2 ins.			
(5) Screen: Size 1/4, Length 6 ft.			
(6) Were any formations sealed against pollution? <input checked="" type="checkbox"/> yes, <input type="checkbox"/> no.			
If YES depth of formation 1 to 42 ft.			
Why surface water			
Drillers Remarks:			

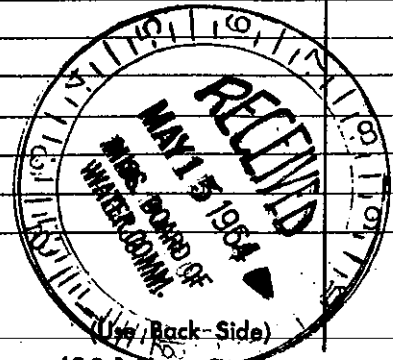

Well No.

Mail this copy to Board of Water Commissioners 429 Miss. St. Jackson, Miss.