

LAUD. MISSISSIPPI BOARD OF WATER COMMISSIONERS

06

6-4-64

WATER WELL DRILLERS LOG

Date: 6/4, 1964, Driller: Jerry [unclear] OVERSTREET County LAUD.

(Name)

		Description & Color of Materials Sand, Clay, Red Clay, Shell, etc.	Thick- ness Feet	Depth Feet
(1) Owner of Land: <u>Boy Scout Camp</u> (Name)				
<u>Rt 7, Meridian, Miss.</u> (Address)		<u>yellow clay & sand</u>	<u>50</u>	<u>50</u>
(2) Location: <u>1/4</u> , <u>1/4</u> , Sec. <u>35</u> T <u>R</u>		<u>blue dirt & sandy shale</u>	<u>300</u>	<u>350'</u>
<u>7</u> miles <u>EAST</u> of <u>MdN.</u> (distance) (direction) (Nearest Town)		<u>fine sand streaks</u>	<u>137'</u>	<u>437'</u>
(3) Topography: _____ (Hilly) (Flat) (Level)		<u>hard blue dirt</u>	<u>65'</u>	<u>502'</u>
(4) Purpose of Well: <u>DOMESTIC</u> (Domestic Irrigation Municipal, Industrial, Other)		<u>SAND</u>	<u>90</u>	<u>591'</u>

Information upon completion of well:


- (1) Diameter 5 1/2 inches.
- (2) Total Depth 591 feet.
- (3) Water Level 325 feet below top of ground.
- (4) Cased to 500', Size 5 1/2"
- (5) Screen: Size 2 1/2", Length 40'
- (6) Were any formations sealed against pollution?
 yes, _____ no.

If YES depth of formation: SURFACE CASING

Why: CEMENTED

Drillers Remarks: Well pumped

75 gpm

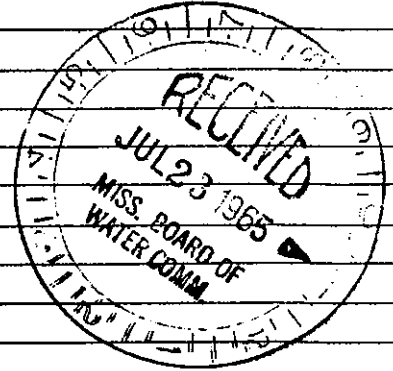

Well