

LAUD.

07

11-14-64

MISSISSIPPI BOARD OF WATER COMMISSIONERS

WATER WELL DRILLERS LOG

Date: 11-14, 1964, Driller: Bob Williams County Lauderdale

(Name)

(1) Owner of Land	Description & Color of Materials Sand, Clay, Red Clay, Shell, etc.	Thick- ness Feet	Depth Feet
S.M. Boyette (Name) Pt. 6 Box 126, Meridian (Address)	Red clay	10	1-10
(2) Location: W 1/4, SW 1/4, Sec. 17 T6 R12	white sand	3.5	10-45
10 miles East, of Meridian (distance) (direction) (Nearest Town)	Blue clay	25.5	45-300
(3) Topography: hilly (Hilly) (Flat) (Level)	gray sand	50	300-350
(4) Purpose of Well: Domestic (Domestic Irrigation Municipal, Industrial, Other)			


Information upon completion of well:

- (1) Diameter 2 inches.
- (2) Total Depth 350 feet.
- (3) Water Level 70 feet below top of ground.
- (4) Cased to 112, Size 2
- (5) Screen: Size 0, Length _____
- (6) Were any formations sealed against pollution?
 yes, no.

If YES depth of formation _____

Why surface water

Drillers Remarks: _____

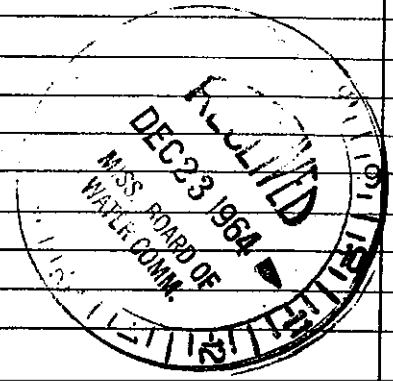

W/C