

Lauderdale

MISSISSIPPI BOARD OF WATER COMMISSIONERS

08
7-66

WATER WELL DRILLERS LOG

Date: 7/23, 1966, Driller: PERRY Drilling Co. County LAUD
(Name)

		Description & Color of Materials Sand, Clay, Red Clay, Shell, etc.	Thick- ness Feet	Depth Feet
(1) Owner of Land:	MAGGIE MAE RAUSON (Name)	SAND & CLAY	0	60
	RT 6 MERIDIAN, MISS (Address)	SHALE & BLUE SAND	60	110
(2) Location:	SE 1/4, NW 1/4, Sec 20 T. 17 N. R. 6 E. (distance) (direction) (Nearest Town)	SHALE	110	340
	7 miles E of MDU. (distance) (direction) (Nearest Town)	SHALE & SAND	340	420
(3) Topography:	(Hilly) (Flat) (Level)			
(4) Purpose of Well:	Domestic (Domestic Irrigation Municipal, Industrial, Other)			


Information upon completion of well:

- (1) Diameter 4 inches.
- (2) Total Depth 420 feet.
- (3) Water Level 180 feet below top of ground.
- (4) Cased to 252, Size 4"
- (5) Screen: Size No, Length _____
- (6) Were any formations sealed against pollution?
_____ yes, _____ no.

If YES depth of formation _____

Why _____

Drillers Remarks: _____

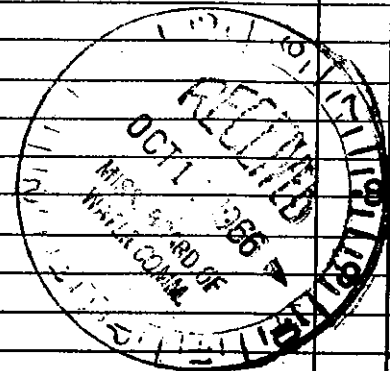

(Use Back Side)

Well No.

Mail this copy to Board of Water Commissioners 429 Miss. St. Jackson, Miss.