

Lauderdale

010

12-66

MISSISSIPPI BOARD OF WATER COMMISSIONERS

WATER WELL DRILLERS LOG


Date: 12-16 66, 19 66, Driller: M^e Donald & Hill County Lauderdale

(When well drilled)

(Name)

(Where well is located)

		Description & Color of Materials Sand, Clay, Red Clay, Shell, etc.	Thick- ness Feet	Dep Fe
(1) Owner of Land:	AMOS HUTTON (Name)			
	RUSSELL MISS (Address)	Clay SAND	28	28
		Sand	7	35
(2) Location:	NE 1/4, SE 1/4, Sec. 5 T6 R12, 2 miles SOUTH of RUSSELL (distance) (direction) (Nearest Town)	SHALE ST SAND	25	60
		SHALE	210	27
		Sand & Shell	10	28
		SOFT SHALE	32	31
		Sand	8	32
(3) Topography:	X (Hilly) (Flat) (Level)	Thin sand & shale	22	34
(4) Purpose of Well:	DOMESTIC (Domestic Irrigation Municipal, Industrial, Other)	Sandy Shell	18	36
Information upon completion of well:				
(1) Diameter:	3 7/8 inches. TEST HOLE			
(2) Total Depth:	360' feet.			
(3) Water Level:	220' feet below top of ground.			
(4) Cased to:	253', Size 4"			
(5) Screen:	Size none, Length _____			
(6) Were any formations sealed against pollution?	_____ yes, <u>X</u> no.			
If YES depth of formation:	_____			
Why:	_____			
Drillers Remarks:	_____			
Yield in gpm:	20			
Size pump:	3 1/2 P SUBMERSIBLE			
Type power:	220			

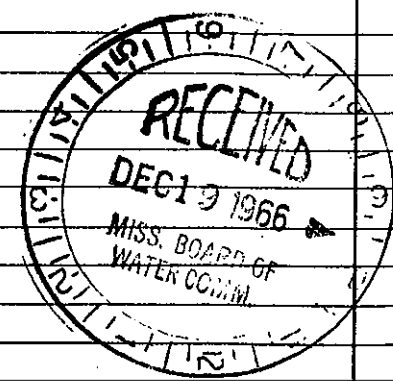

Mail this copy to Board of Water Commissioners 429 Miss. St. Jackson, Miss.