

LAUD.

#014


7-22-64

WATER WELL DRILLERS LOG

Date: 7.22, 1964, Driller: M. E. Donald & H. Hill Inc. County: Lauderdale

(Name)

		Description & Color of Materials Sand, Clay, Red Clay, Shell, etc.	Thick- ness Feet	Depth Feet
(1) Owner of Land: <u>Wayne Smith</u> (Name)				
<u>Rt #3, Meridian</u> (Address)		<u>CLAY</u>	<u>0</u>	<u>18</u>
		<u>SAND</u>	<u>18</u>	<u>38</u>
		<u>SHALE</u>	<u>38</u>	<u>100</u>
(2) Location: <u>1/4</u> , <u>1/4</u> , Sec. <u>31</u> <u>6N19E</u> T. R.		<u>SANDY SHALE FINE SAND</u>	<u>100</u>	<u>130</u>
<u>6</u> miles <u>East</u> , of <u>Meridian</u> (distance) (direction) (Nearest Town)				
(3) Topography: <u>X</u> (Hilly) (Flat) (Level)				
(4) Purpose of Well: <u>DOMESTIC</u> (Domestic Irrigation Municipal, Industrial, Other)				
Information upon completion of well:				
(1) Diameter: <u>3 1/4</u> inches. <u>TEST HOLE</u>				
(2) Total Depth: <u>130'</u> feet.				
(3) Water Level: <u>55'</u> feet below top of ground.				
(4) Cased to <u>84'</u> , Size <u>2"</u>				
(5) Screen: Size _____, Length _____				
(6) Were any formations sealed against pollution? _____ yes, _____ no.				
If YES depth of formation _____				
Why _____				
Drillers Remarks: _____				

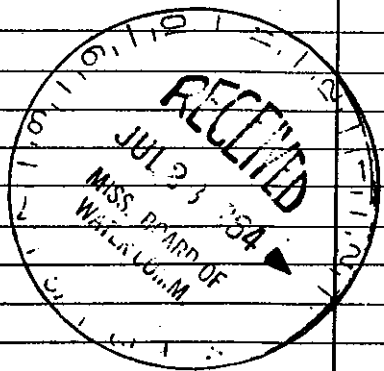

(Use Back Side)

Well No.

Mail this copy to Board of Water Commissioners 429 Miss. St. Jackson, Miss