

LAUD. MISSISS.
 018
 4-8-66

WATER WELL DRILLERS LOG

Date: 4/8, 1966, Driller: TERRY County LAUD
 (Name)

		Description & Color of Materials Sand, Clay, Red Clay, Shell, etc.	Thick- ness Feet	Depth Feet
(1) Owner of Land: <u>RONNIE MASSEY</u> (Name) <u>RT6 MERIDIAN</u> (Address)		<u>YELLOW SAND & CLAY</u>	<u>0</u>	<u>30</u>
(2) Location: <u>7 1/4</u> Sec. <u>17E</u> <u>5</u> miles <u>E</u> of <u>MDN.</u> (distance) (direction) (Nearest Town)		<u>BLUE dirt & SHALE</u>	<u>30</u>	<u>140</u>
(3) Topography: <input checked="" type="checkbox"/> (Hilly) <input type="checkbox"/> (Flat) <input type="checkbox"/> (Level)		<u>SANDY</u>	<u>140</u>	<u>165</u>
(4) Purpose of Well: <u>DOMESTIC</u> (Domestic Irrigation Municipal, Industrial, Other)		<u>HARD SHALE</u>	<u>165</u>	<u>340</u>
		<u>SANDY</u>	<u>340</u>	<u>401</u>


Information upon completion of well:

- (1) Diameter 4 inches.
 (2) Total Depth 401 feet.
 (3) Water Level 135' feet below top of ground.
 (4) Cased to 210, Size 4"
 (5) Screen: Size No, Length _____
 (6) Were any formations sealed against pollution?
 _____ yes, _____ no.

If YES depth of formation _____

Why _____

Drillers Remarks: Good WATER

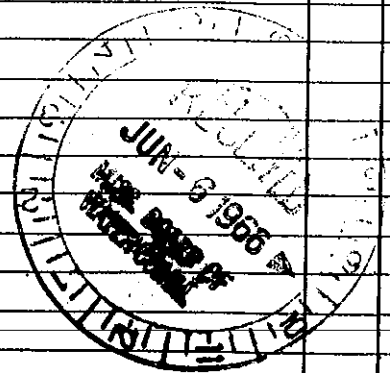

Well